
HAROLD H. KOLB

REGISTERED PROFESSIONAL LAND SURVEYOR LAKE GENEVA, WISCONSIN

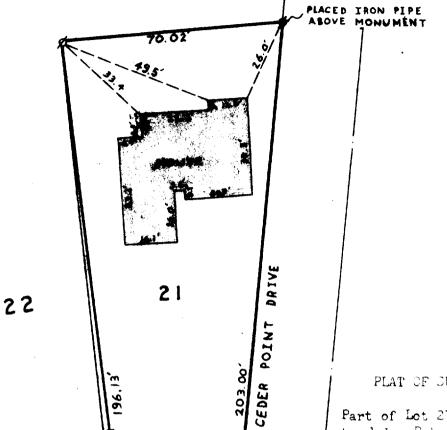

PLAT OF JURVEY OF

Part of Lot 21, First Additio to Gedar Point Park, Village of Williams Bay, Walworth County, Wisconsin.

SCALE : 1":30"

LEGEND

- IRON PIPE FOUND

- IRON PIPE PLACED

- CONCRETE MONUMENT


(3.03)

25.67

BIRCH-WALNUT ROAD

- SPIKE

() - AS DEEDED

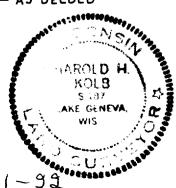

I. HAROLD H. KOLB, DO HEREBY CERTIFY THAT I HAVE SURVEYED THE PROPERTY HEREON DESCRIBED ACCORDING TO THE OFFICIAL RECORDS, AND THAT THE PLAT HEREON IS A CORRECT REPRESENTATION OF THE LOT LINES.

HAROLD H. KOLB WISCONSIN REGISTERED LAND SURVEYOR, S-187

DATE June 27, 1973

11-24