PREPARED FOR PATRICIA DUDA PO. BOX 813 WILLIAMS BAY WI. 53191


PLAT OF SURVEY

- OF -

KROTT SURVEYING INC.

N3705 WILLOW BEND LANE LAKE GENEVA WI. 53147 PHONE # (262)248-3697 FAX # (262)249-0639

LOT 166 IN CEDAR POINT PARK SECOND ADDITION IN THE VILLAGE OF WILLIAMS BAY, WALWORTH COUNTY, WISCONSIN.

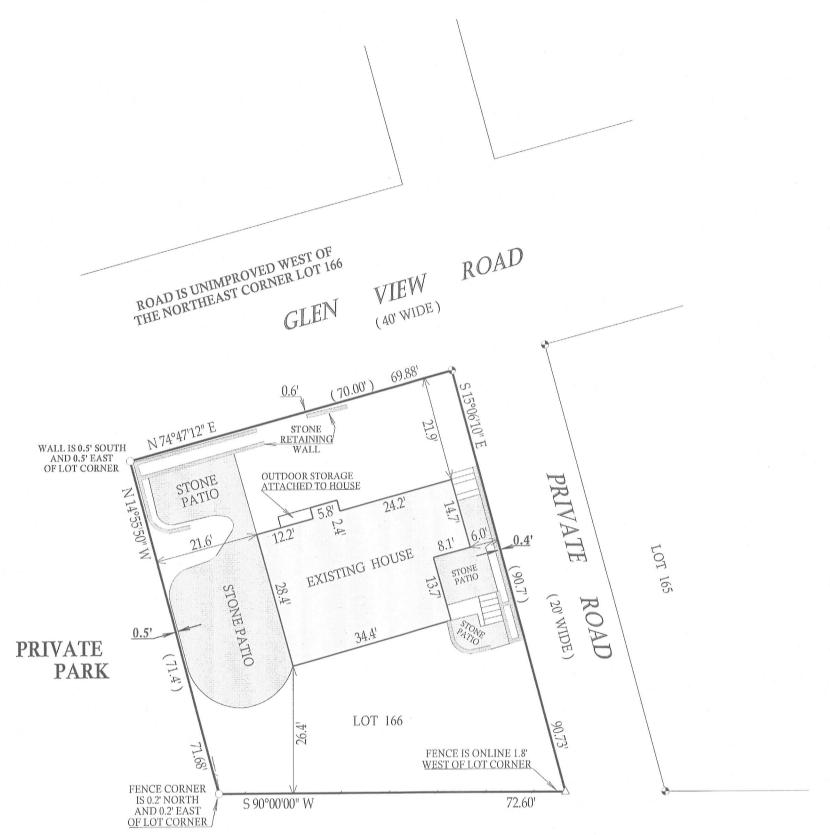

ROAD IS UNIMPROVED WEST OF THE SOUTHEAST CORNER LOT 166

WILMETTE ROAD (40') WIDE




LEGEND

- O FOUND IRON PIPE
- △ FOUND P.K. NAIL
- FOUND CONCRETE MONUMENT

(XX) RECORDED AS

TAX ID # WCP200058


JOB # 07-380UD

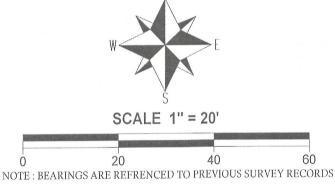

LOT 191

I have surveyed the above-described property and the above map is a true representation thereof and shows the size and location of the property, its exterior boundaries, the location and dimensions of all structures thereon, fences apparent easements and roadways and visible encroachments. if any.

This survey is made for the exclusive use of the present owners of the property, and also those who puchase, mortgage, or insure the title therto within one (1) year from date hereof; and as to them I warrant the accuracy of said survey map.

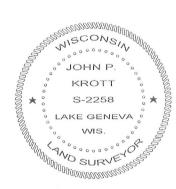

DATED THIS 13th DAY OF SEPTEMBER 2012

John Marth

JOHN KROTT S - 2258 Wisconsin Registered Land Surveyor (original if signed in red)