


FARRIS, HANSEN & ASSOCIATES, INC.

ENGINEERING - ARCHITECTURE - SURVEYING
 7 RIDGWAY COURT - P.O. BOX 437 - ELKHORN, WISCONSIN 53121
 PHONE: (262) 723-2098 FAX: (262) 723-5886

PLAT OF SURVEY

LOT 7, EXCEPT THE WEST 10' THERE OF AND THE WEST 10' OF LOT 8
 OF GLENWOOD ESTATES SUBDIVISION, VILLAGE OF WILLIAMS BAY,
 WALWORTH COUNTY, WISCONSIN




- WORK ORDERED BY -
 KEEFE REAL ESTATE
 PO BOX 480
 LAKE GENEVA, WI 53147

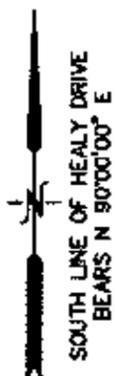

HEALY DRIVE

{40' WIDE R.O.W.}

EDGE OF PAVEMENT

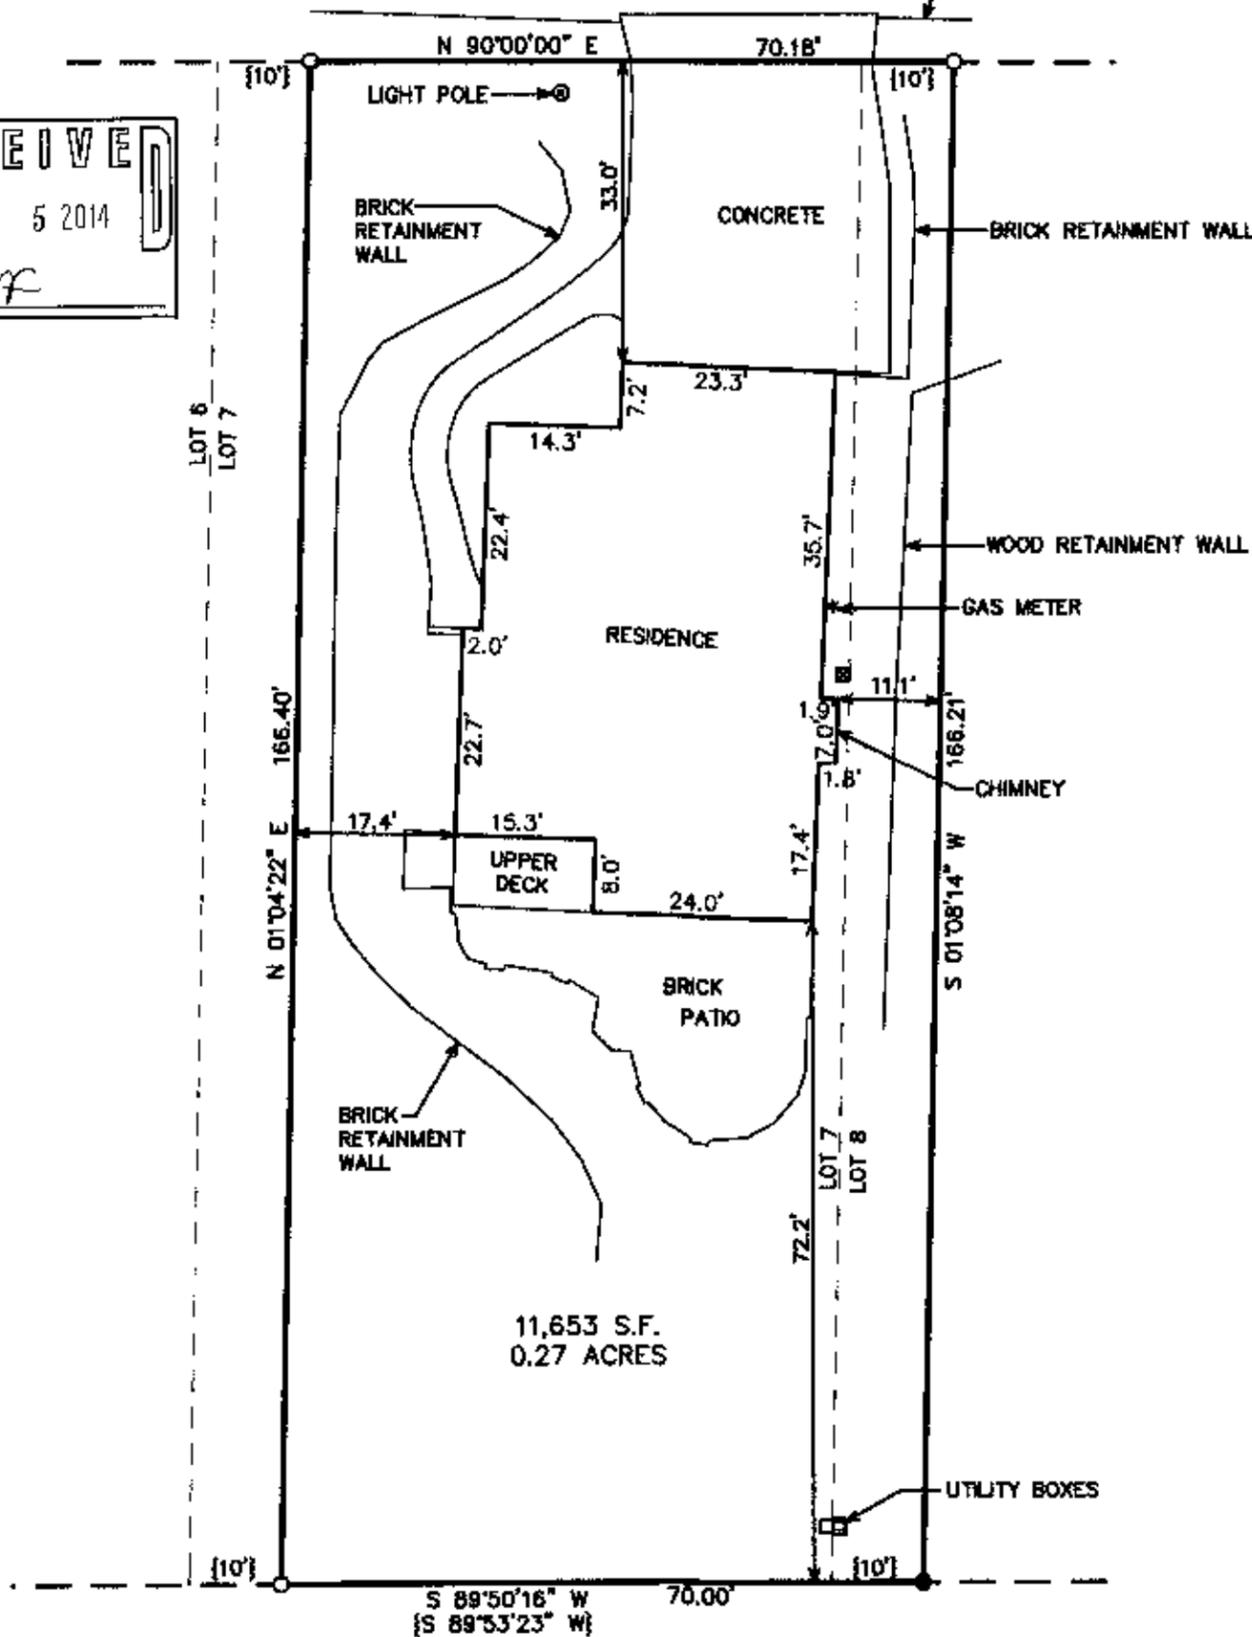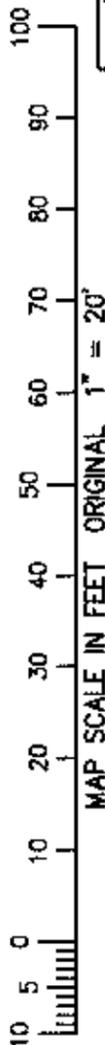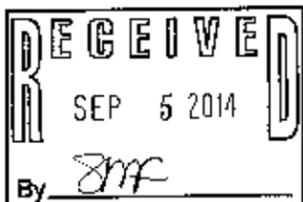


Lot 7, EXCEPT the Western 10 feet thereof said Lot 7, and the West 10 feet of Lot 8, Glenwood Estates Subdivision, according to the recorded plat thereof. Said land being in the Village of Williams Bay, County of Walworth, State of Wisconsin.
 FOR INFORMATIONAL PURPOSES ONLY:
 Property Address: 85 Healy Dr., Williams Bay, WI 53191
 Tax Key Number: WGE-00007

NOTE: COPIES OF THIS MAP TO WHICH THE FOLLOWING CERTIFICATE WILL APPLY SHOW THE SURVEYOR'S ORIGINAL SEAL AND SIGNATURE IN RED INK. COPIES BY ANY OTHER MEANS MAY HAVE ALTERATIONS WHICH DO NOT REPRESENT THE SURVEYOR'S WORK PRODUCT.

I HEREBY CERTIFY THAT THE ABOVE DESCRIBED PROPERTY HAS BEEN SURVEYED UNDER MY DIRECTION AND THAT THE ABOVE MAP IS A TRUE REPRESENTATION THEREOF AND SHOWS THE SIZE AND LOCATION OF THE PROPERTY, ITS EXTERIOR BOUNDARIES, THE LOCATION OF ALL VISIBLE STRUCTURES, AND DIMENSIONS OF ALL PRINCIPLE BUILDINGS THEREON, BOUNDARY FENCES, APPARENT EASEMENTS, ROADWAYS, AND VISIBLE ENCROACHMENTS, IF ANY. THIS SURVEY IS MADE FOR THE USE OF THE PRESENT OWNERS OF THE PROPERTY, AND ALSO THOSE WHO PURCHASE, MORTGAGE, OR GUARANTEE THE TITLE THERETO WITHIN ONE YEAR FROM THE DATE HEREOF.

DATED: AUGUST 25, 2014

Peter S. Gordon
 PETER S. GORDON

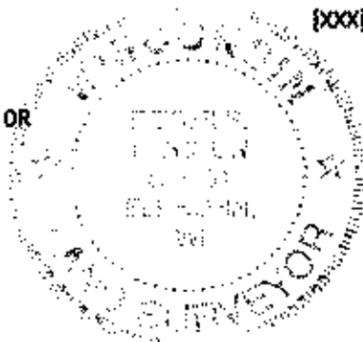

- LEGEND
- = IRON PIPE STAKE FOUND
 - = IRON REBAR STAKE FOUND
 - {XXX} = RECORDED AS

PROJECT: 9105
 DATE: 8/22/2014
 SHEET 1 OF 1

8/25/2014 X:\Projects\9105\Doc\A\TISUB