


PLAT OF SURVEY

- OF -



PATHFINDER SURVEYING INC.
(formerly)
J.K. SURVEYING INC.
P.O BOX 322
LAKE GENEVA, WI. 53147
WWW.PATHFINDERSURVEYING.NET
262-248-8303

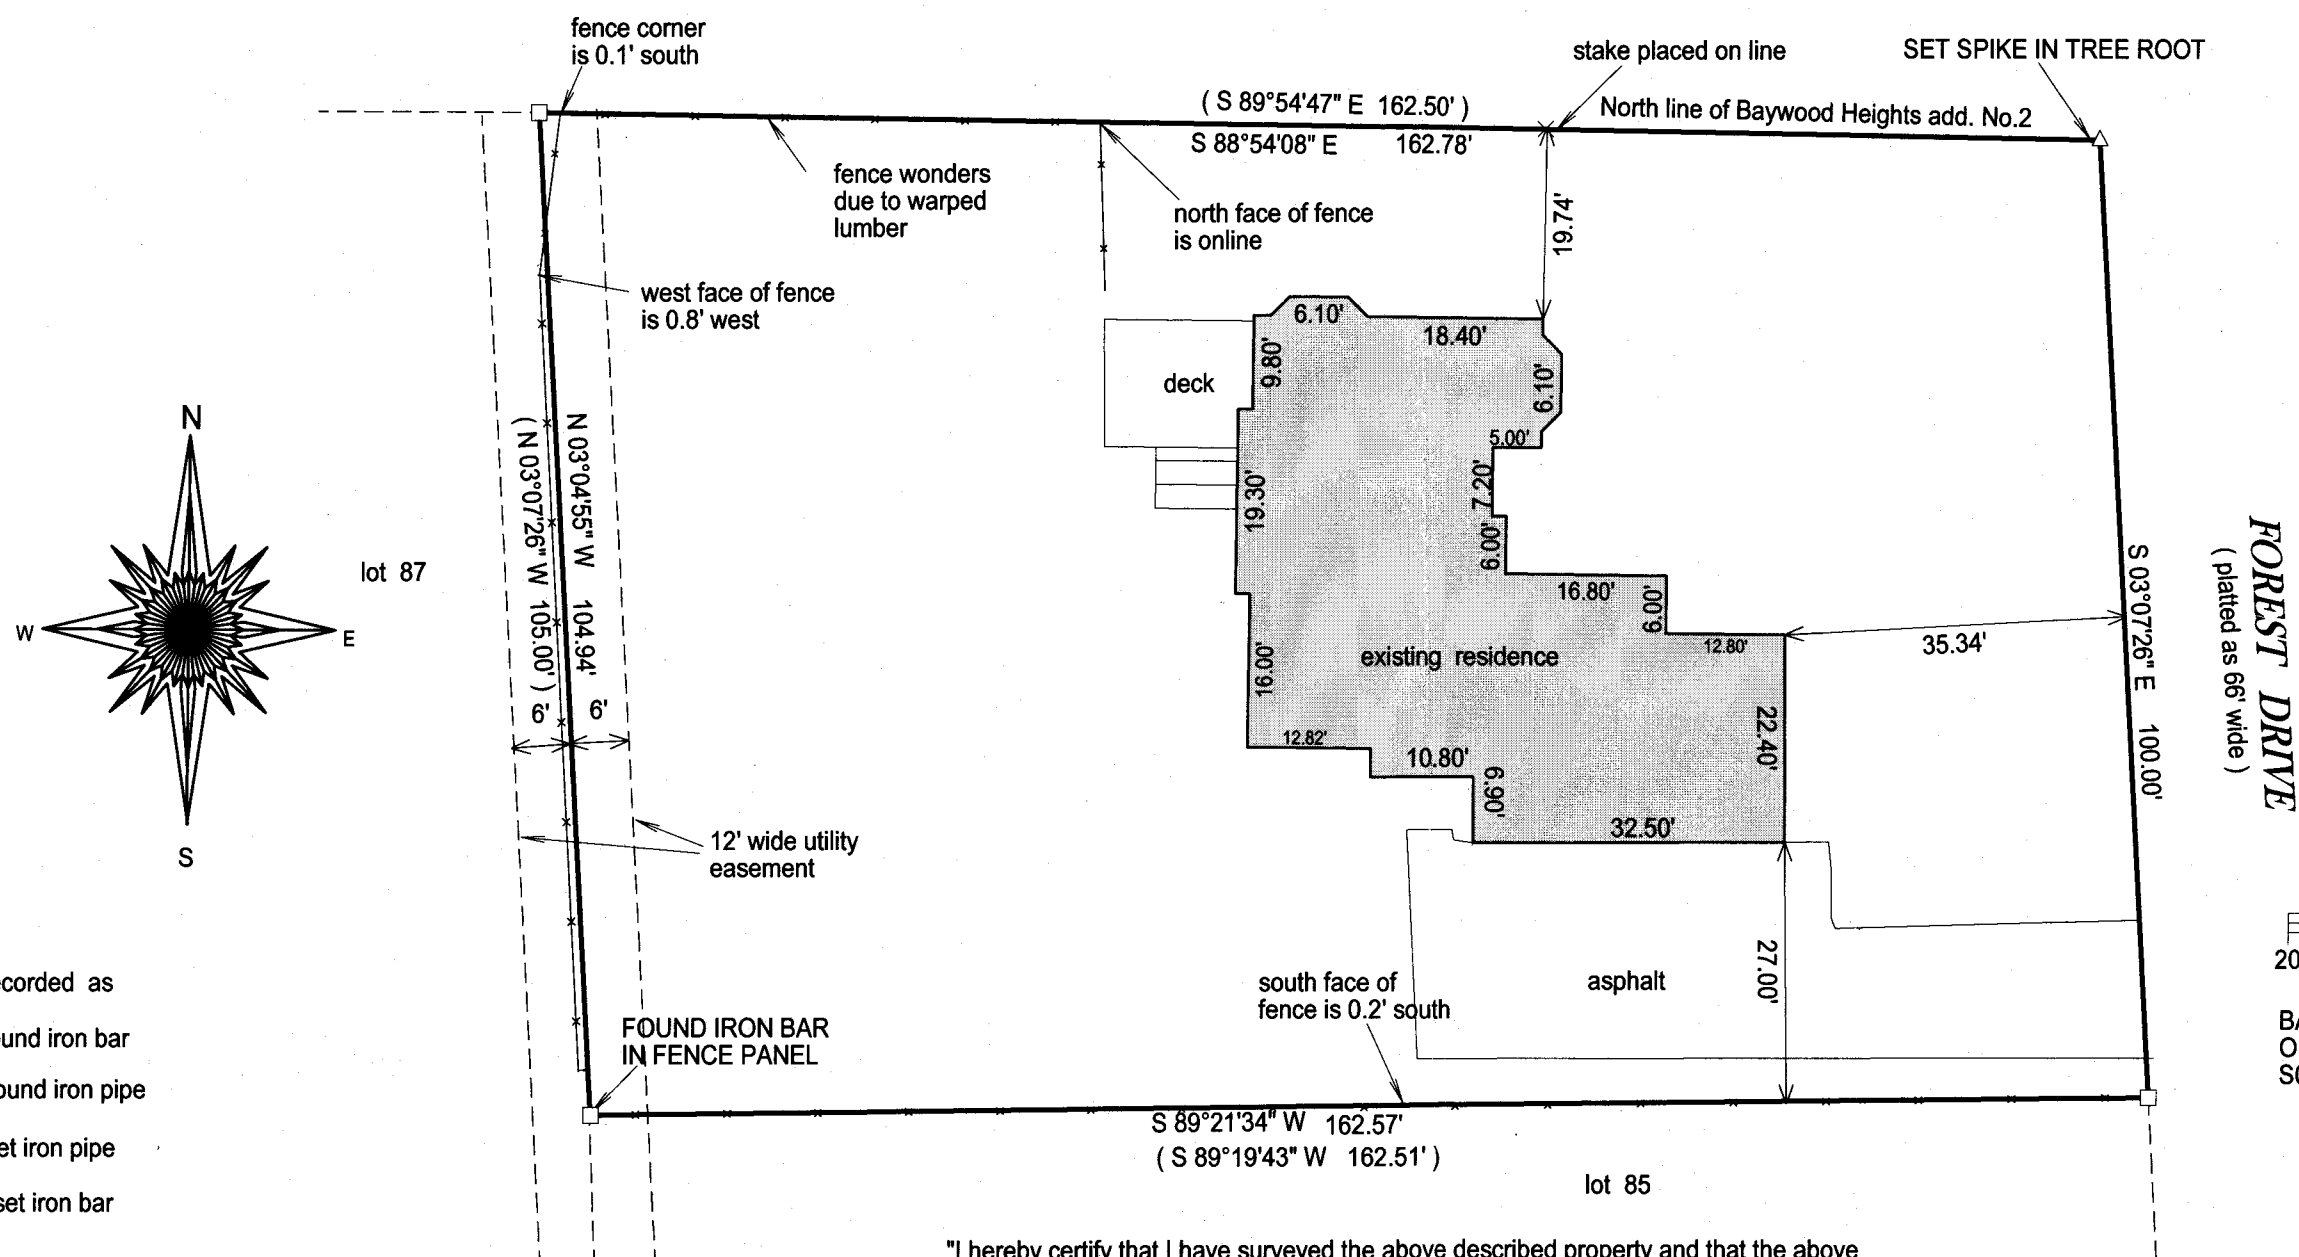

TAX ID # WBW200037

DATED THIS 7TH DAY OF JUNE, 2014.

FOREST DRIVE
(platted as 66' wide)

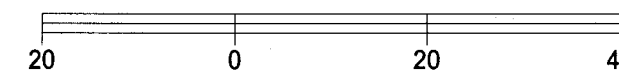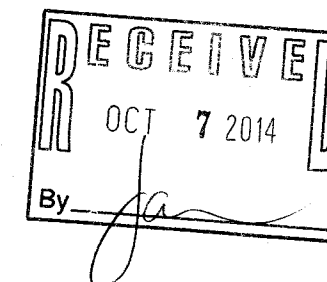

BASIS OF BEARING OF THIS PLAT: THE WEST LINE
OF FOREST DRIV WAS ASSUMED TO BEAR
S03°07'26" E AS SHOWN ON THE RECORD PLAT.



WBW2 -37

011-2542