
## FARRIS, HANSEN & ASSOC. INC.

7 RIDGWAY COURT— P.O. BOX 437 ELKHORN, WSCONSIN 53121 PHONE (262) 723—2098 FAX (262) 723—5886

## PLAT OF SURVEY LOT 28 OF BAILEY ESTATES

LOCATED IN PART OF THE NW, NE, SE, & SW 1/4s OF THE NW 1/4 OF SECTION 36, TOWN 2 NORTH, RANGE 16 EAST, VILLAGE OF WILLIAMS BAY, WALWORTH COUNTY, WISCONSIN

ORDERED BY: GERSTADT BUILDERS 4310 G CRYSTAL LAKE ROAD McHENRY, IL. 60050

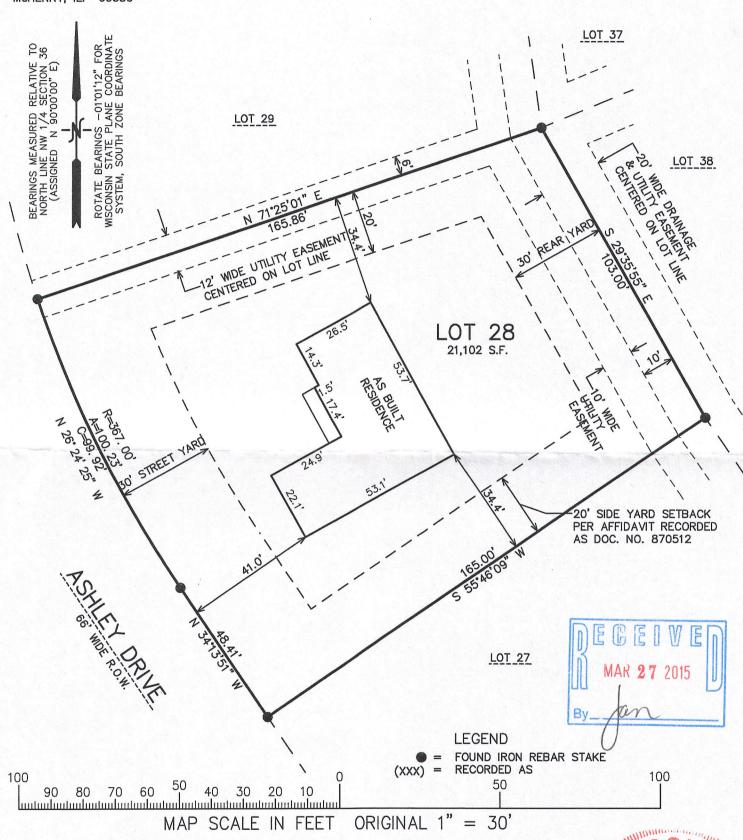

NOTE: COPIES OF THIS MAP TO WHICH THE FOLLOWING CERTIFICATE WILL APPLY SHOW SURVEYOR'S ORIGINAL SEAL AND SIGNATURE IN RED INK. COPIES BY ANY OTHER MEANS MAY HAVE ALTERATIONS WHICH DO NOT REPRESENT THE SURVEYOR'S WORK PRODUCT.

I HEREBY CERTIFY THAT THE ABOVE DESCRIBED PROPERTY HAS BEEN SURVEYED UNDER MY DIRECTION AND THAT THE ABOVE MAP IS A TRUE REPRESENTATION THEREOF AND SHOWS THE SIZE AND LOCATION OF THE PROPERTY AND ITS EXTERIOR BOUNDARIES. THIS SURVEY IS MADE FOR THE USE OF THE PRESENT OWNERS OF THE PROPERTY, AND ALSO THOSE WHO PURCHASE, MORTGAGE, OR GUARANTEE THE TITLE THERETO WITHIN ONE YEAR FROM THE DATE HEREOF.

REVISED 10/9/2014-KB

REVISED 10/9/2014-KB TO SHOW SIZE & LOCATION OF PROPOSED RESIDENCE

REVISED 01-09-2015 TO SHOW SIZE & LOCATION OF AS BUILT RESIDENCE GORDON S-2101 ELKHORN, WI

SHAN

CON

PETER S

DATED: DECEMBER 21, 2005

PETER S. GORDON R.L.S. 2101

Wita & Bridge

PROJECT NO. 3249.28 DATED: 12-21-2005 SHEET 1 OF 1 SHEETS