
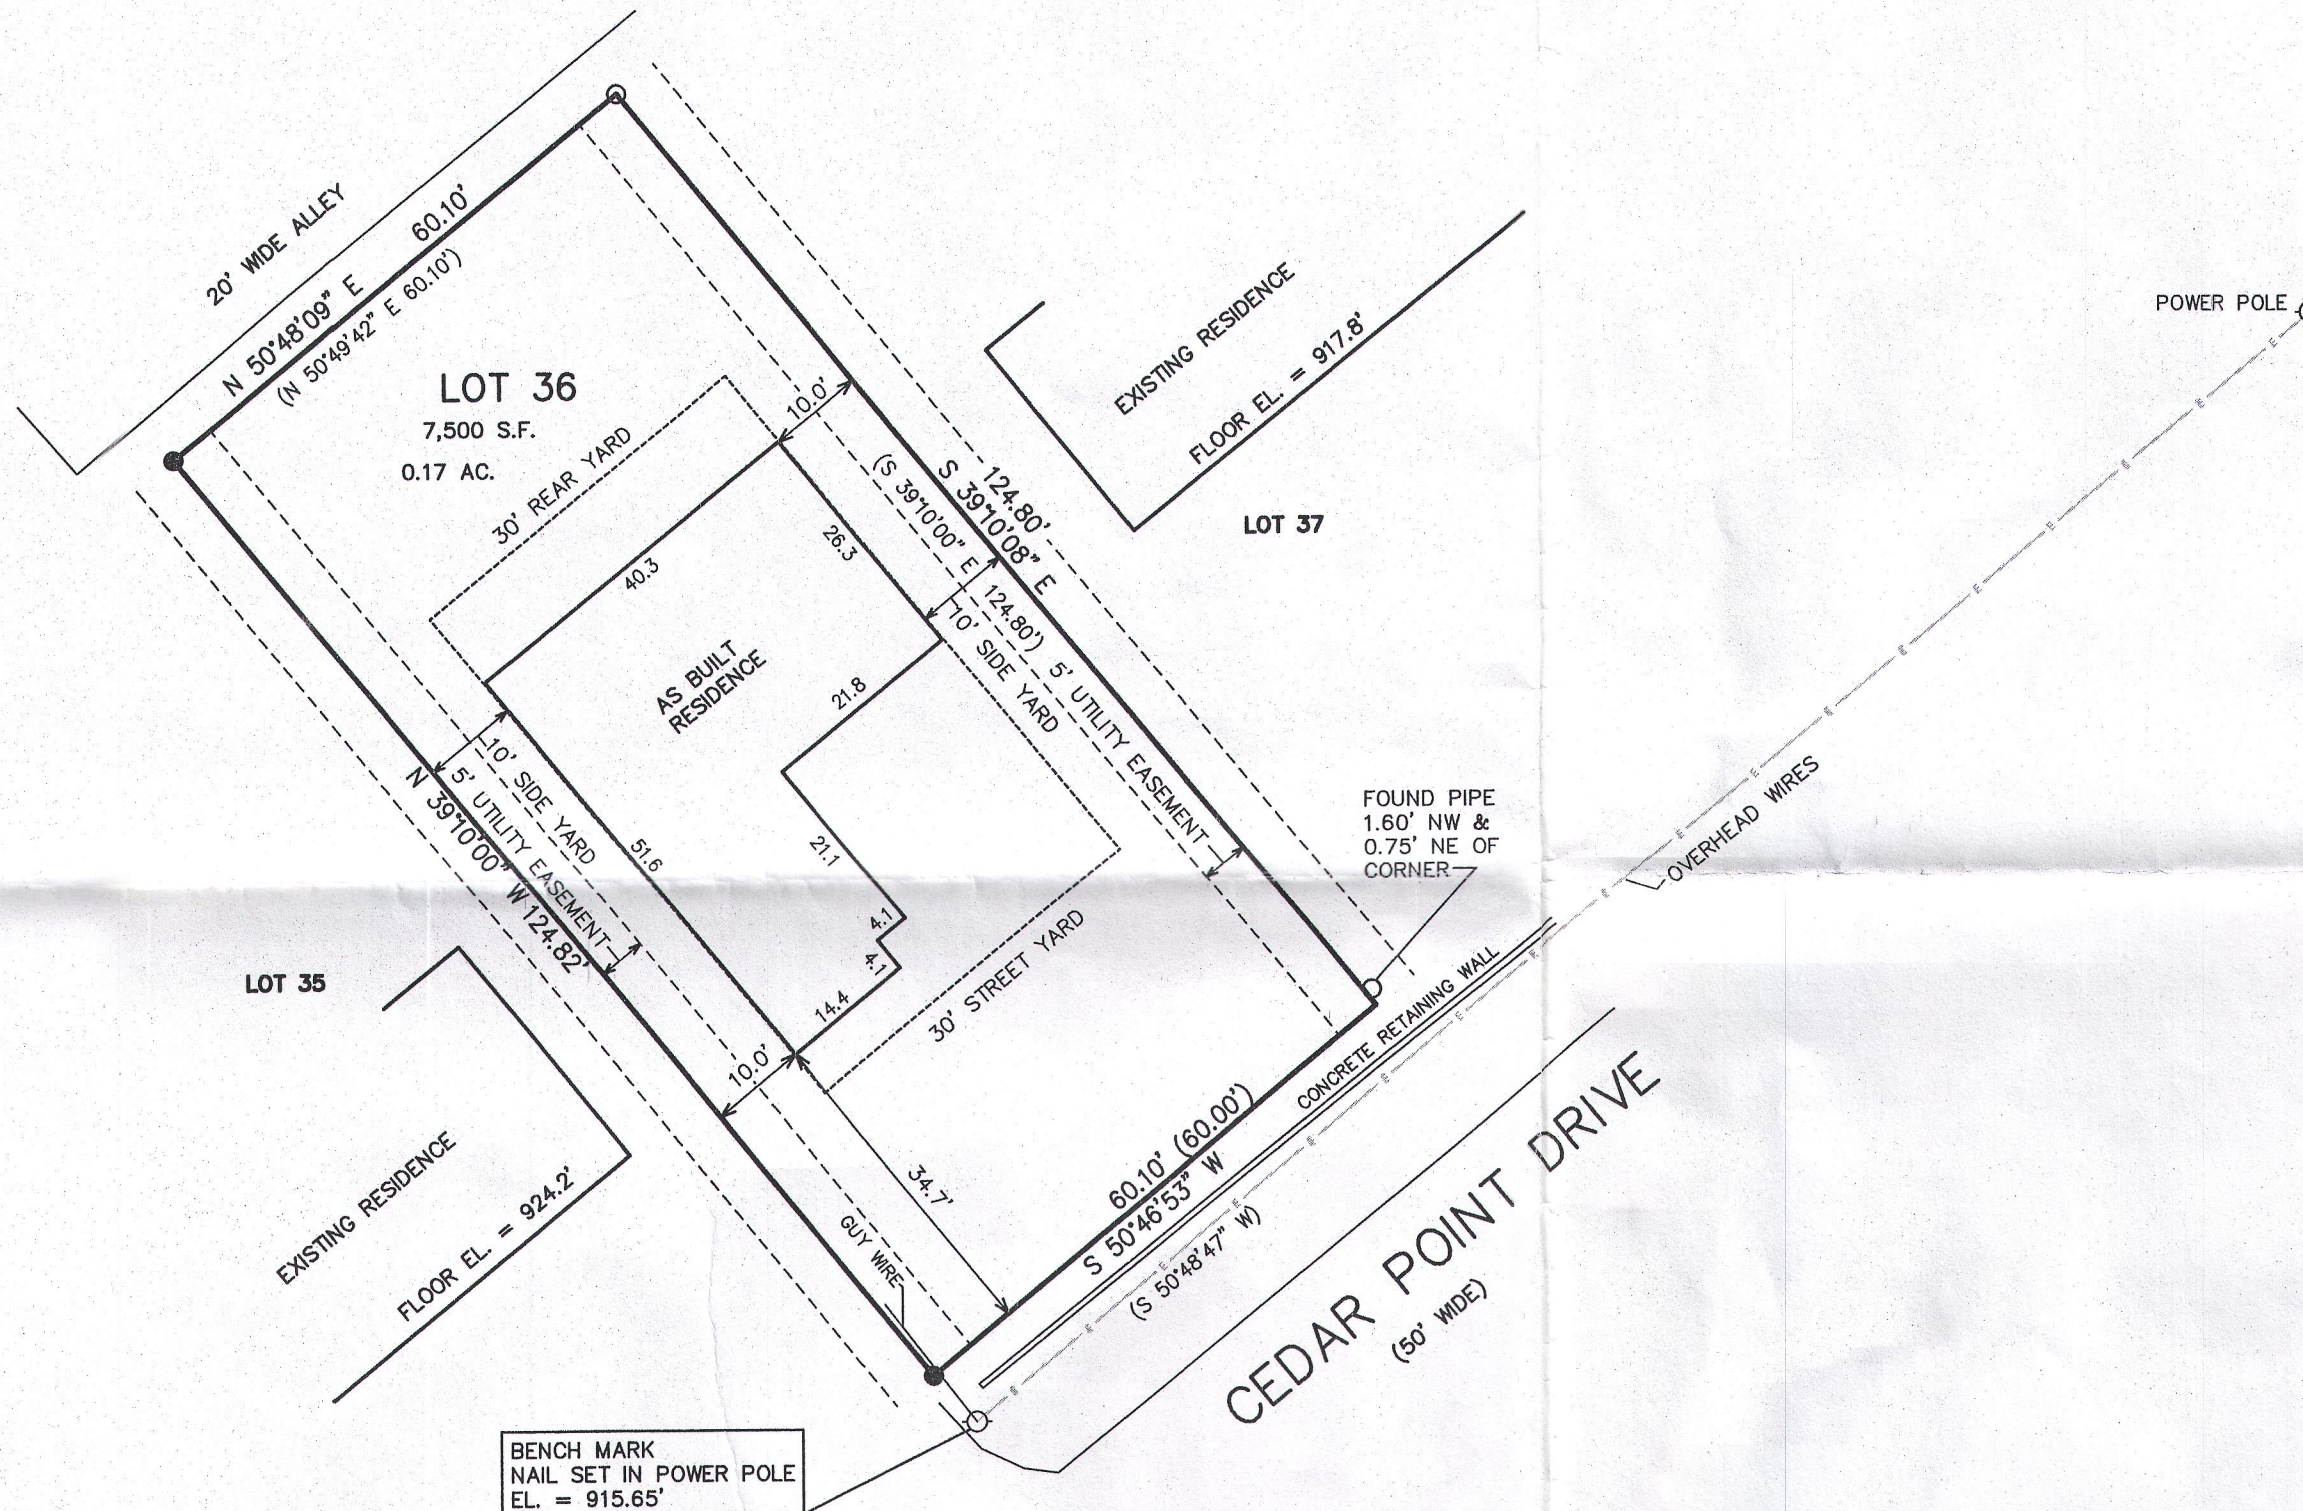


# BOUNDARY SURVEY


## LOT 36 OF CEDAR POINT PARK

PART OF THE SE 1/4 SECTION 6  
TOWN 1 NORTH, RANGE 17 EAST  
VILLAGE OF WILLIAMS BAY  
WALWORTH COUNTY, WISCONSIN

WCP 00027A

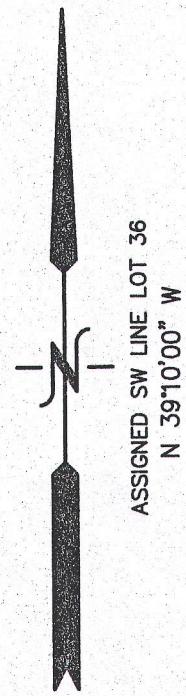

LEGEND  
○ = FOUND IRON PIPE STAKE  
● = FOUND IRON REBAR STAKE  
(XXX) = RECORDED AS

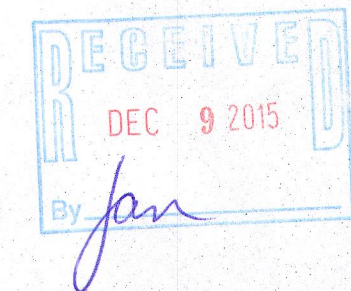



NOTE: COPIES OF THIS MAP TO WHICH THE FOLLOWING CERTIFICATE WILL APPLY SHOW THE SURVEYOR'S ORIGINAL SEAL AND SIGNATURE IN RED INK. COPIES BY ANY OTHER MEANS MAY HAVE ALTERATIONS WHICH DO NOT REPRESENT THE SURVEYOR'S WORK PRODUCT.

I HEREBY CERTIFY THAT THE ABOVE DESCRIBED PROPERTY HAS BEEN SURVEYED UNDER MY DIRECTION AND THAT THE ABOVE MAP IS A TRUE REPRESENTATION THEREOF AND SHOWS THE SIZE AND LOCATION OF THE PROPERTY AND ITS EXTERIOR BOUNDARIES. THIS SURVEY IS MADE FOR THE USE OF THE PRESENT OWNERS OF THE PROPERTY, AND ALSO THOSE WHO PURCHASE, MORTGAGE, OR GUARANTEE THE TITLE THERETO WITHIN ONE YEAR FROM THE DATE HEREOF.

DATED: JANUARY 30, 2015

*Peter S. Gordon*  
PETER S. GORDON P.L.S. 2101

REVISED 08-05-2015  
TO SHOW SIZE & LOCATION OF  
AS BUILT RESIDENCE

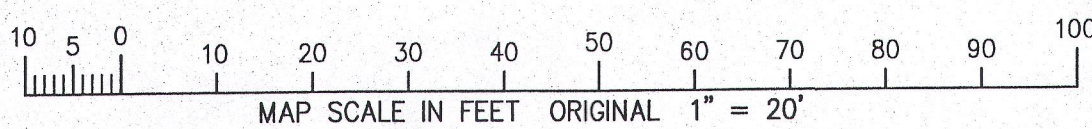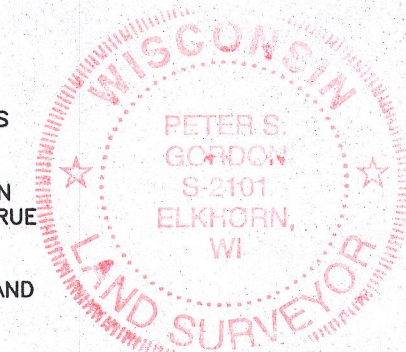

ORDERED BY: AUDREY KLEIN  
2127 BIRCHWOOD AVE  
WILMETTE, IL 60091

FARRIS, HANSEN & ASSOCIATES, INC.  
ENGINEERING - ARCHITECTURE - SURVEYING  
7 RIDGWAY COURT P.O. BOX 437  
ELKHORN, WISCONSIN 53121  
OFFICE: (262) 723-2098 FAX: (262) 723-5886

REVISIONS

PROJECT NO.  
9219  
DATE:  
01-30-2015  
SHEET NO.  
1 OF 1

011-2610