
PREPARED FOR: TRICIA FORBECK KEEFE REAL ESTATE LAKE GENEVA, WI.

## PLAT OF SURVEY

- OF -

PATHFINDER SURVEYING INC. (formerly) J.K. SURVEYING INC. P.O BOX 322 LAKE GENEVA, WI. 53147 WWW.PATHFINDERSURVEYING.NET 262-248-8303

UNIT 5, TOGETHER WITH SAID UNIT'S UNDIVIDED INTEREST IN THE COMMON ELEMENTS (AND THE EXCLUSIVE USE OF THE LIMITED COMMON ELEMENTS APPURTENANT TO SAID UNIT) ALL IN DARTMOUTH WOODS CONDOMINIUM F/K/A/ STAM WOODS CONDOMINIUM, A CONDOMINIUM DECLARED AND EXISTING UNDER VIRTUE OF THE CONDOMINIUM OWNERSHIP ACT OF THE STATE OF WISCONSIN AND RECORDED BY A DECLARATION AS SUCH CONDOMINIUM IN THE OFFICE OF THE REGISTER OF DEEDS FOR WALWORTH COUNTY, WISCONSIN, ON NOVEMBER 11, 1983, IN VOLUME 313 OF RECORDS, AT PAGE 178 THROUGH 206, AS DOCUMENT No. 96565; AMENDMENT TO DECLARATION RECORDED DECEMBER 17, 1984, IN VOLUME 336 OF RECORDS AT PAGE 27, AS DOCUMENT No. 110234, AND AMENDMENT TO BY-LAWS RECORDED JANUARY 3, 2008 AS DOCUMENT No. 726719, SAID CONDOMINIUM BEING LOCATED IN THE VILLAGE OF WILLIAMS BAY, COUNTY OF WALWORTH, STATE OF WISCONSIN ON THE REAL ESTATE DESCRIBED IN SIAD DECLARATION AND INCORPORATED HEREIN BY THIS REFERENCE THERETO. BY THIS REFERENCE THERETO.

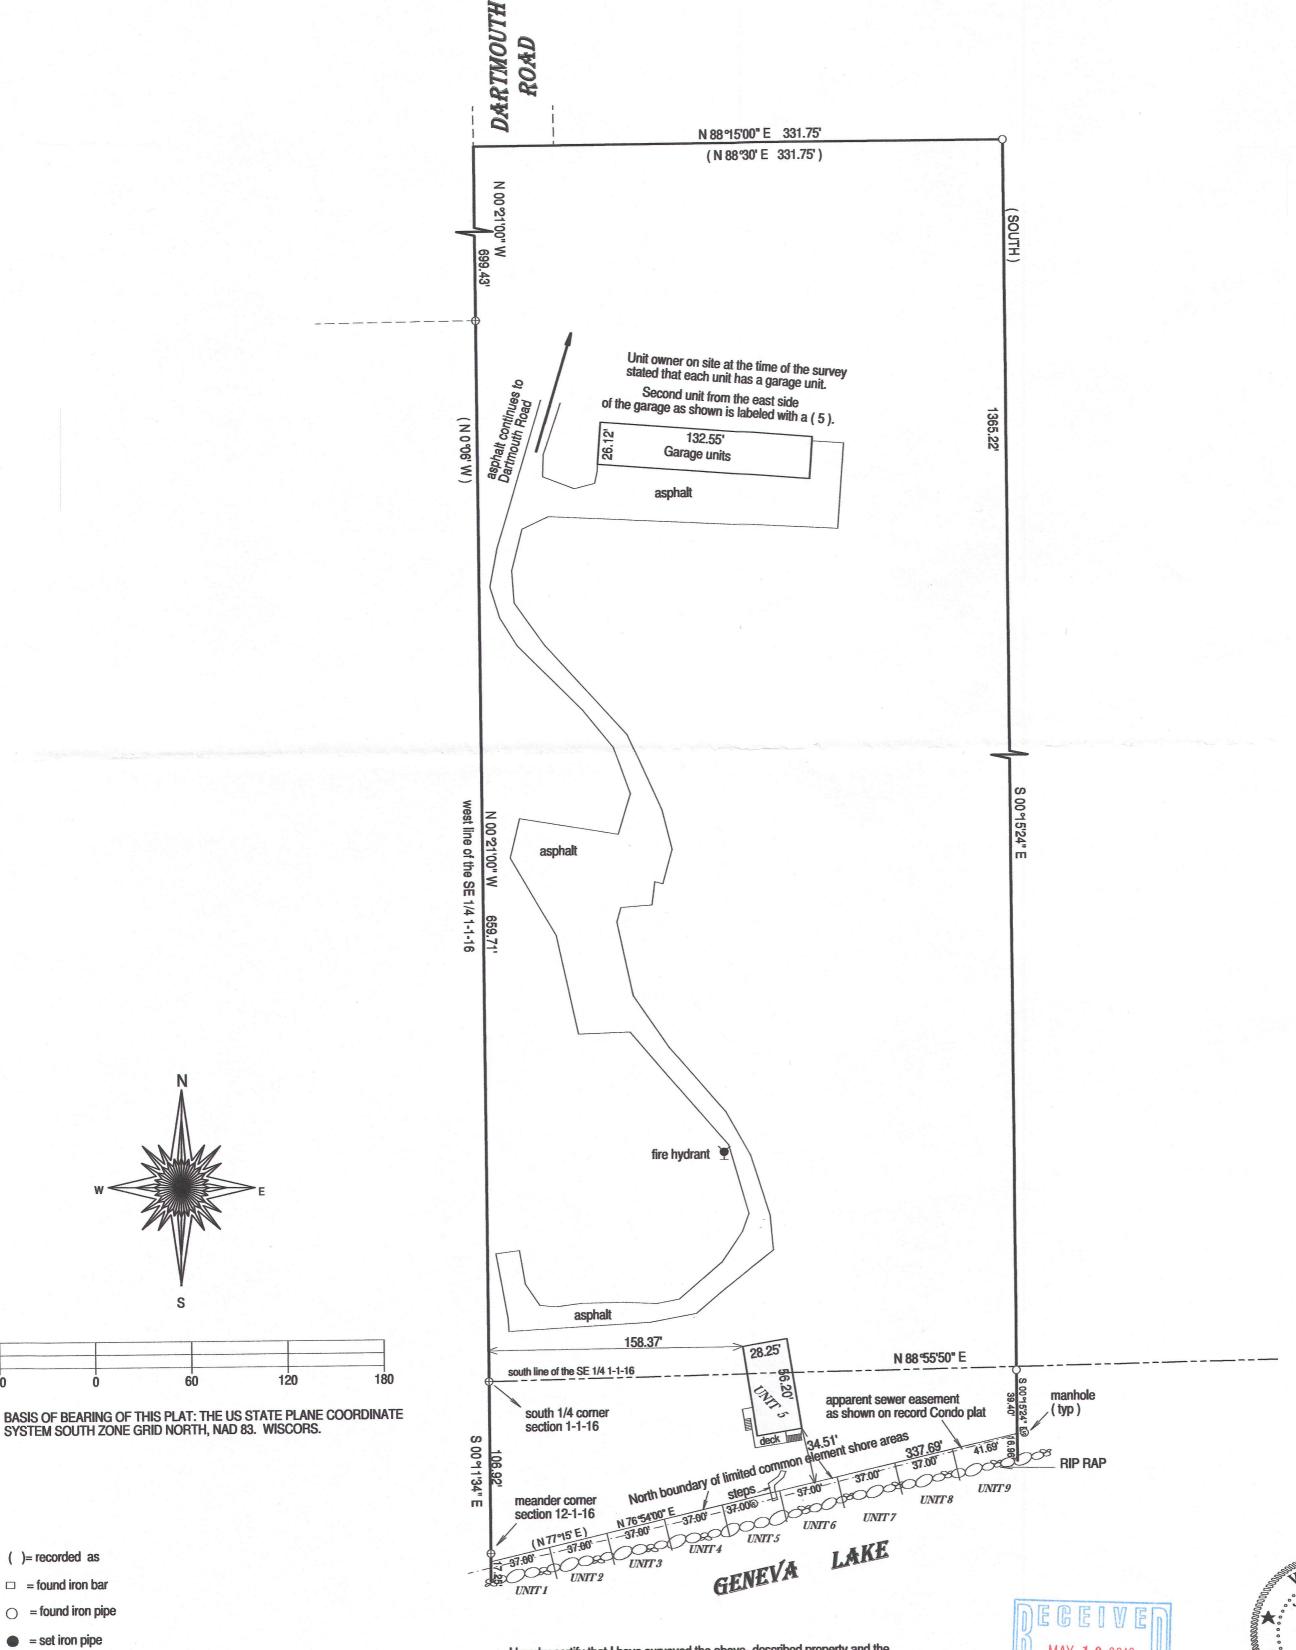

( )= recorded as

 $\Box$  = found iron bar

= found iron pipe

= set iron pipe

= set iron bar SCALE 1" = 60'


JOB # 16-23

TAX ID # WDA 00005

I hereby certify that I have surveyed the above- described property and the above map is a is a true representation thereof and shows the size and location of the property, its exterior boundaries, the location and dimensions of all structures thereon, fences, apparant easements and roadways and visible encroachments if any.

This survey is made for the present owners of the property, and those who purchase, mortgage, or guarantee the title thereto, within one year from the date hereof.

DATED THIS 14TH DAY OF FEBRUARY, 2016.

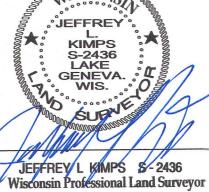

( original if signed in red )