PREPARED FOR KATHY HANSON 391 HAWTHORNE ST. WILLIAMS BAY, WI. 53191

JOB # 16-285

TAX ID #

WLAK 00025

## PLAT OF SURVEY

- OF -

PATHFINDER SURVEYING INC.

(formerly)

J.K. SURVEYING INC.

P.O BOX 322

LAKE GENEVA, WI. 53147


WWW.PATHFINDERSURVEYING.NET
262-248-8303

JEFFREY L KIMPS S-2436

(original if signed in red)

Wisconsin Professional Land Surveyor

LOT 7, BLOCK 2, LAKEWOOD TRAILS SUBDIVISION, LOCATED IN THE NE 1/4 AND NW 1/4 OF THE NW 1/4 OF SECTION 1, TOWN 1 NORTH, RANGE 16 EAST, VILLAGE OF WILLIAMS BAY, WALWORTH COUNTY WISCONSIN.

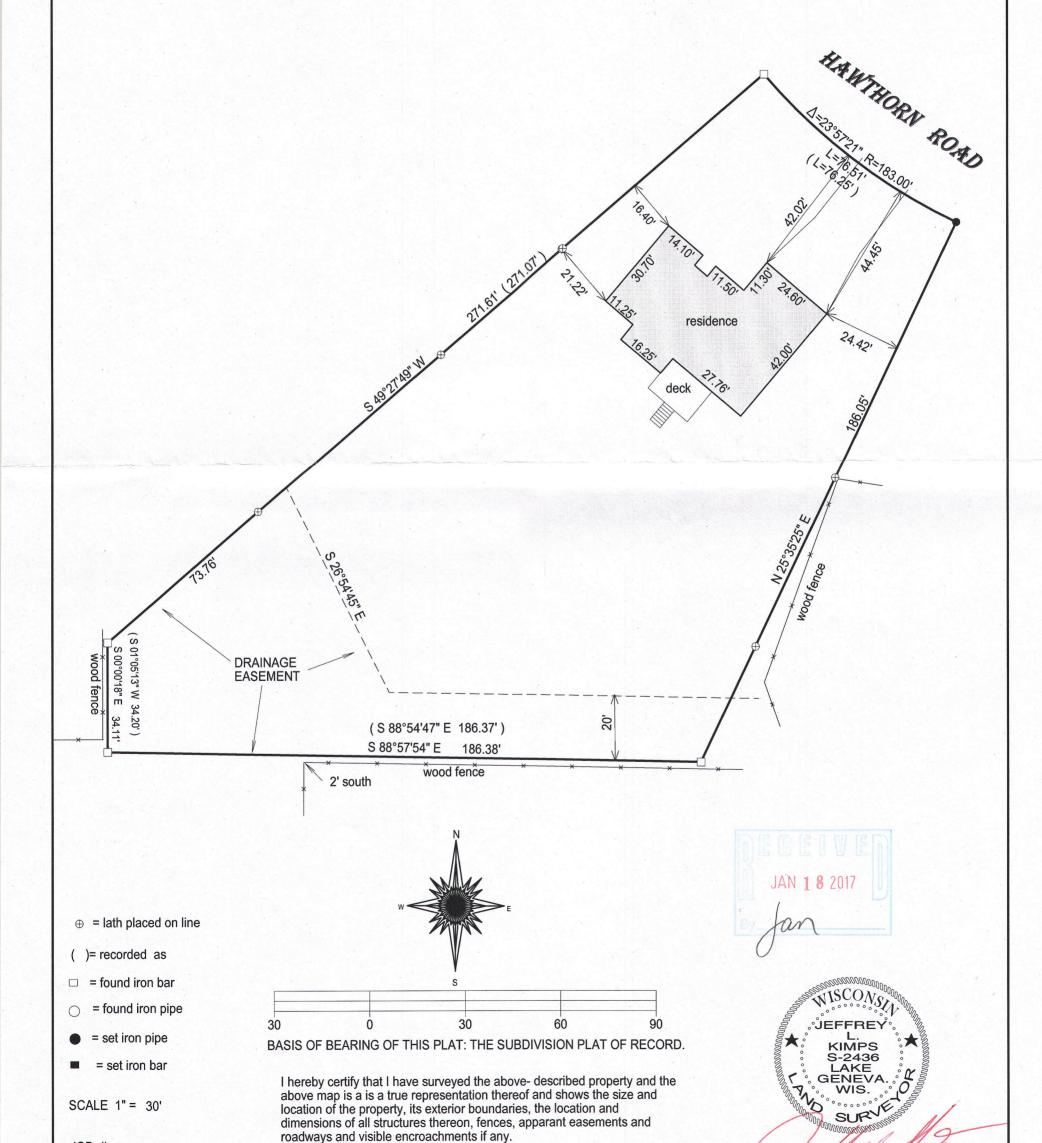

This survey is made for the present owners of the property, and those who purchase, mortgage, or guarantee the title thereto, within one year from

DATED THIS 14th day of September, 2016.

the date hereof.