


# PLAT OF SURVEY

OF

lots 45 & 43 of Bay View Subdivision, Village of Williams Bay, Wisconsin

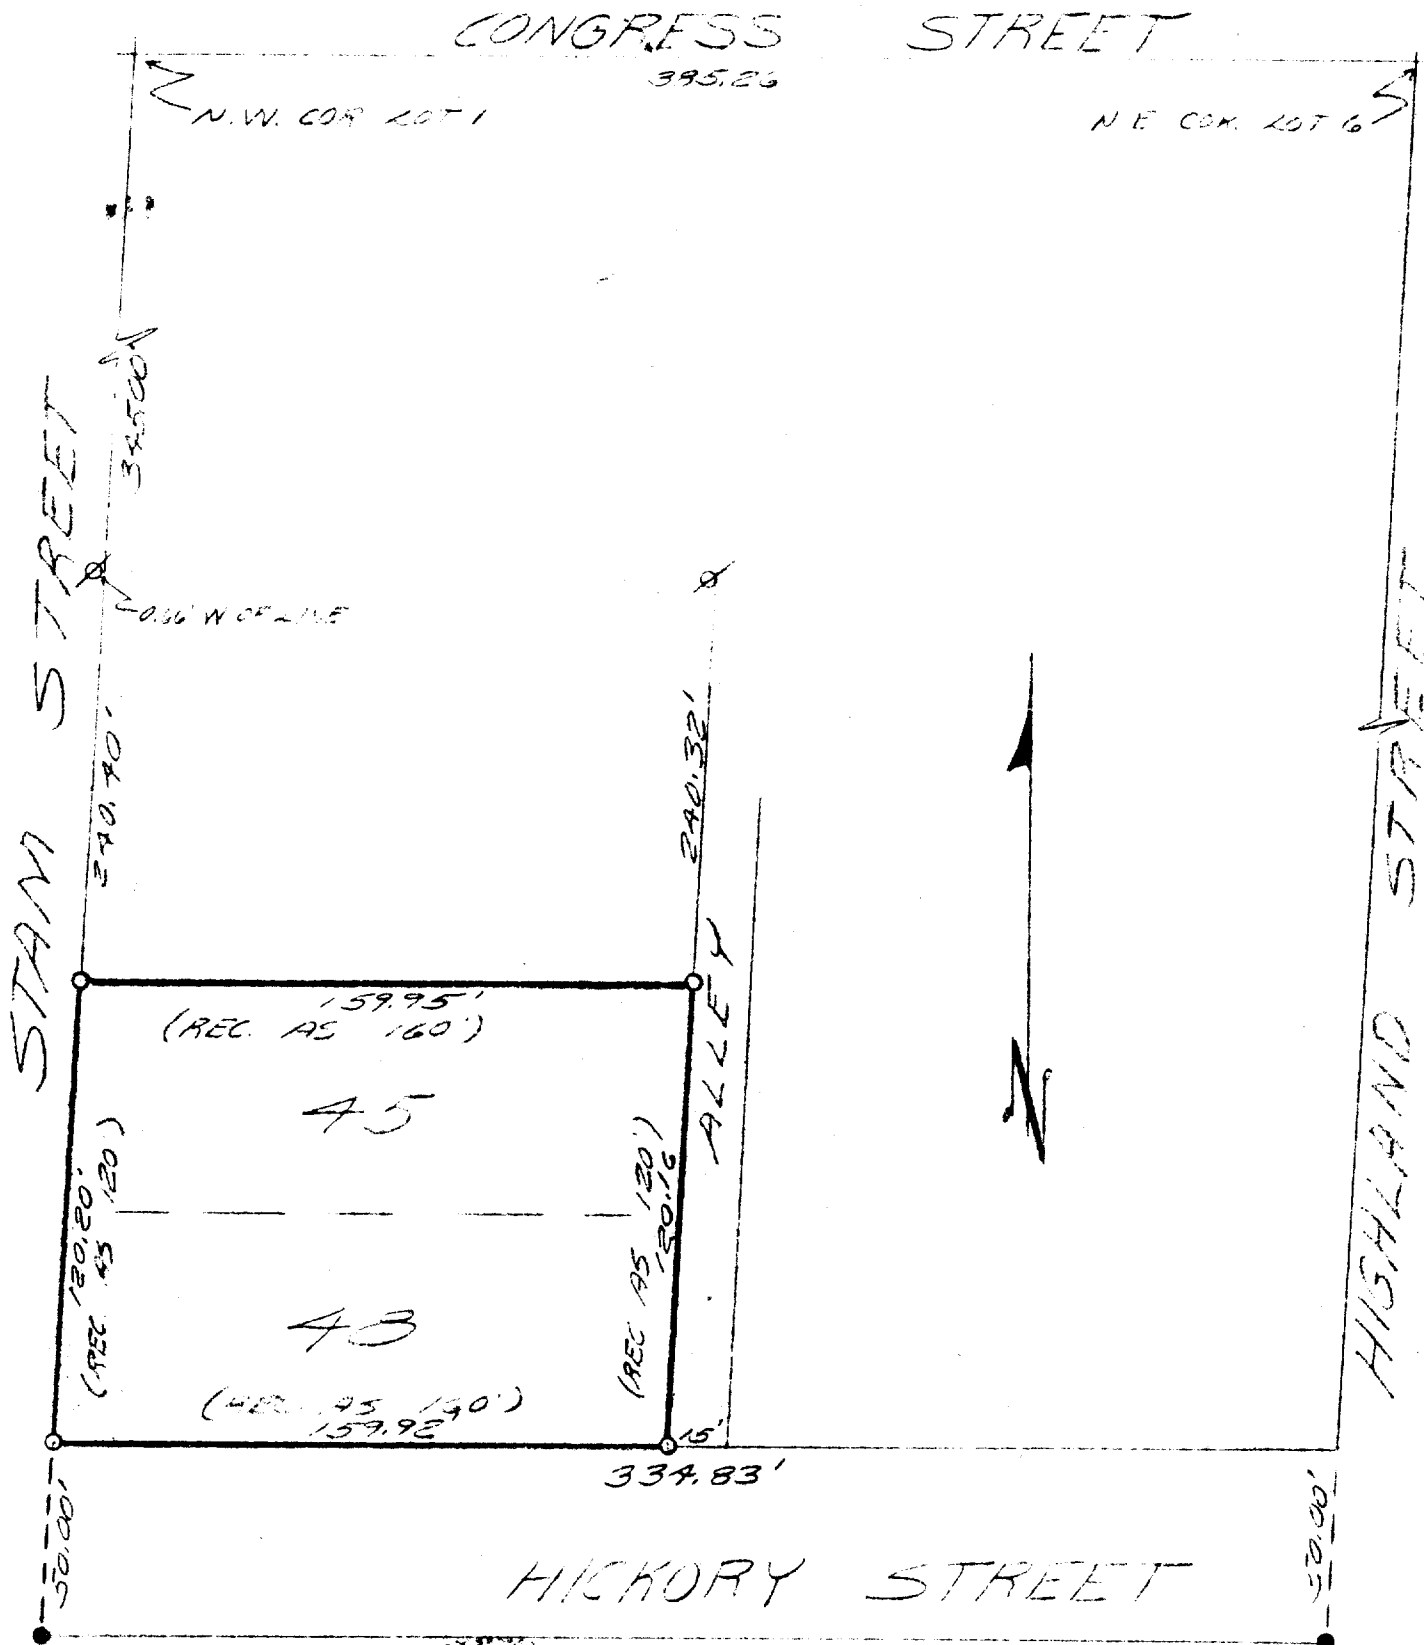

SURVEY AND PLAT BY

**JENSEN & JOHNSON, INC.**

CIVIL ENGINEERS AND SURVEYORS

Elkhorn, Wisconsin

## LEGEND

- ⊗ — Iron Pipe Found
- — Concrete Monument
- Scale 1" = 50'
- — Iron Pipe Set

WE CERTIFY that we have surveyed the above described property and that the plat shown hereon is an accurate survey and a true representation thereof and correctly shows the exterior boundary lines and all divisions of said property.

Date 20 Apr. 1973

*Lloyd L. Jensen*  
LLOYD L. JENSEN,

Wisconsin Registered Land Surveyor, No. S-211