## LAND-MARK SURVEYING Mark L. Miritz


Wisconsin Professional Land Surveyor S-2582

**N9330 Knuteson Drive** Whitewater, WI 53190 Phone:(262)495-3284 MARKMIRITZ@ LAND-MARKSURVEYING.COM

## PLAT OF SURVEY

LOT 73, BAY VIEW SUBDIVISION, LOCATED IN THE SOUTHEAST 1/4 OF SECTION 1, TOWN 1 NORTH, RANGE 16 EAST, VILLAGE OF

ORDERED BY: STACEY SCHULTZ **KEEFE REAL ESTATE 751 GENEVA PARKWAY LAKE GENEVA, WI 53147** 

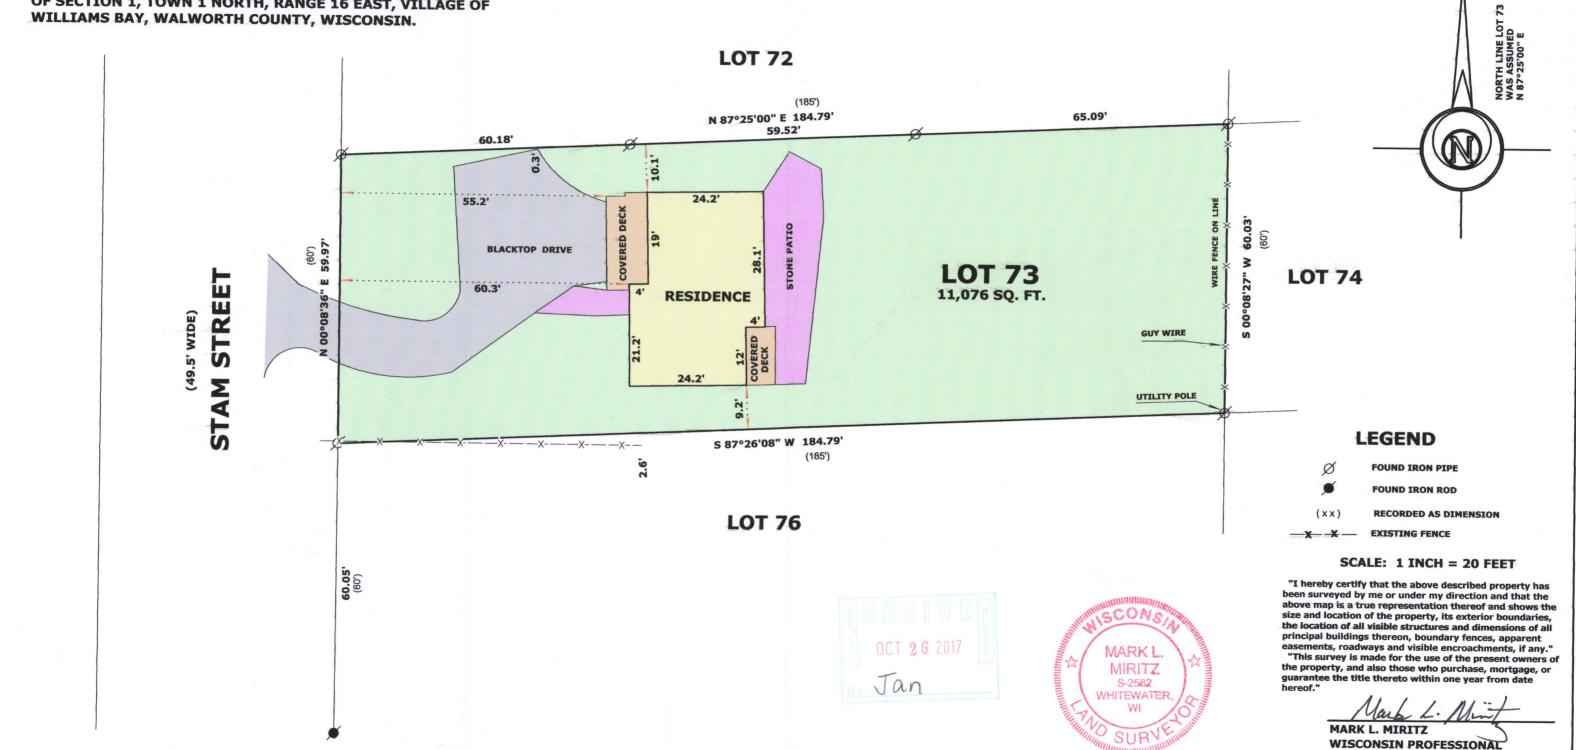

**LAND SURVEYOR S-2582** DATE: SEPT. 19, 2017 JOB NO. 17.911