



PLAT OF SURVEY

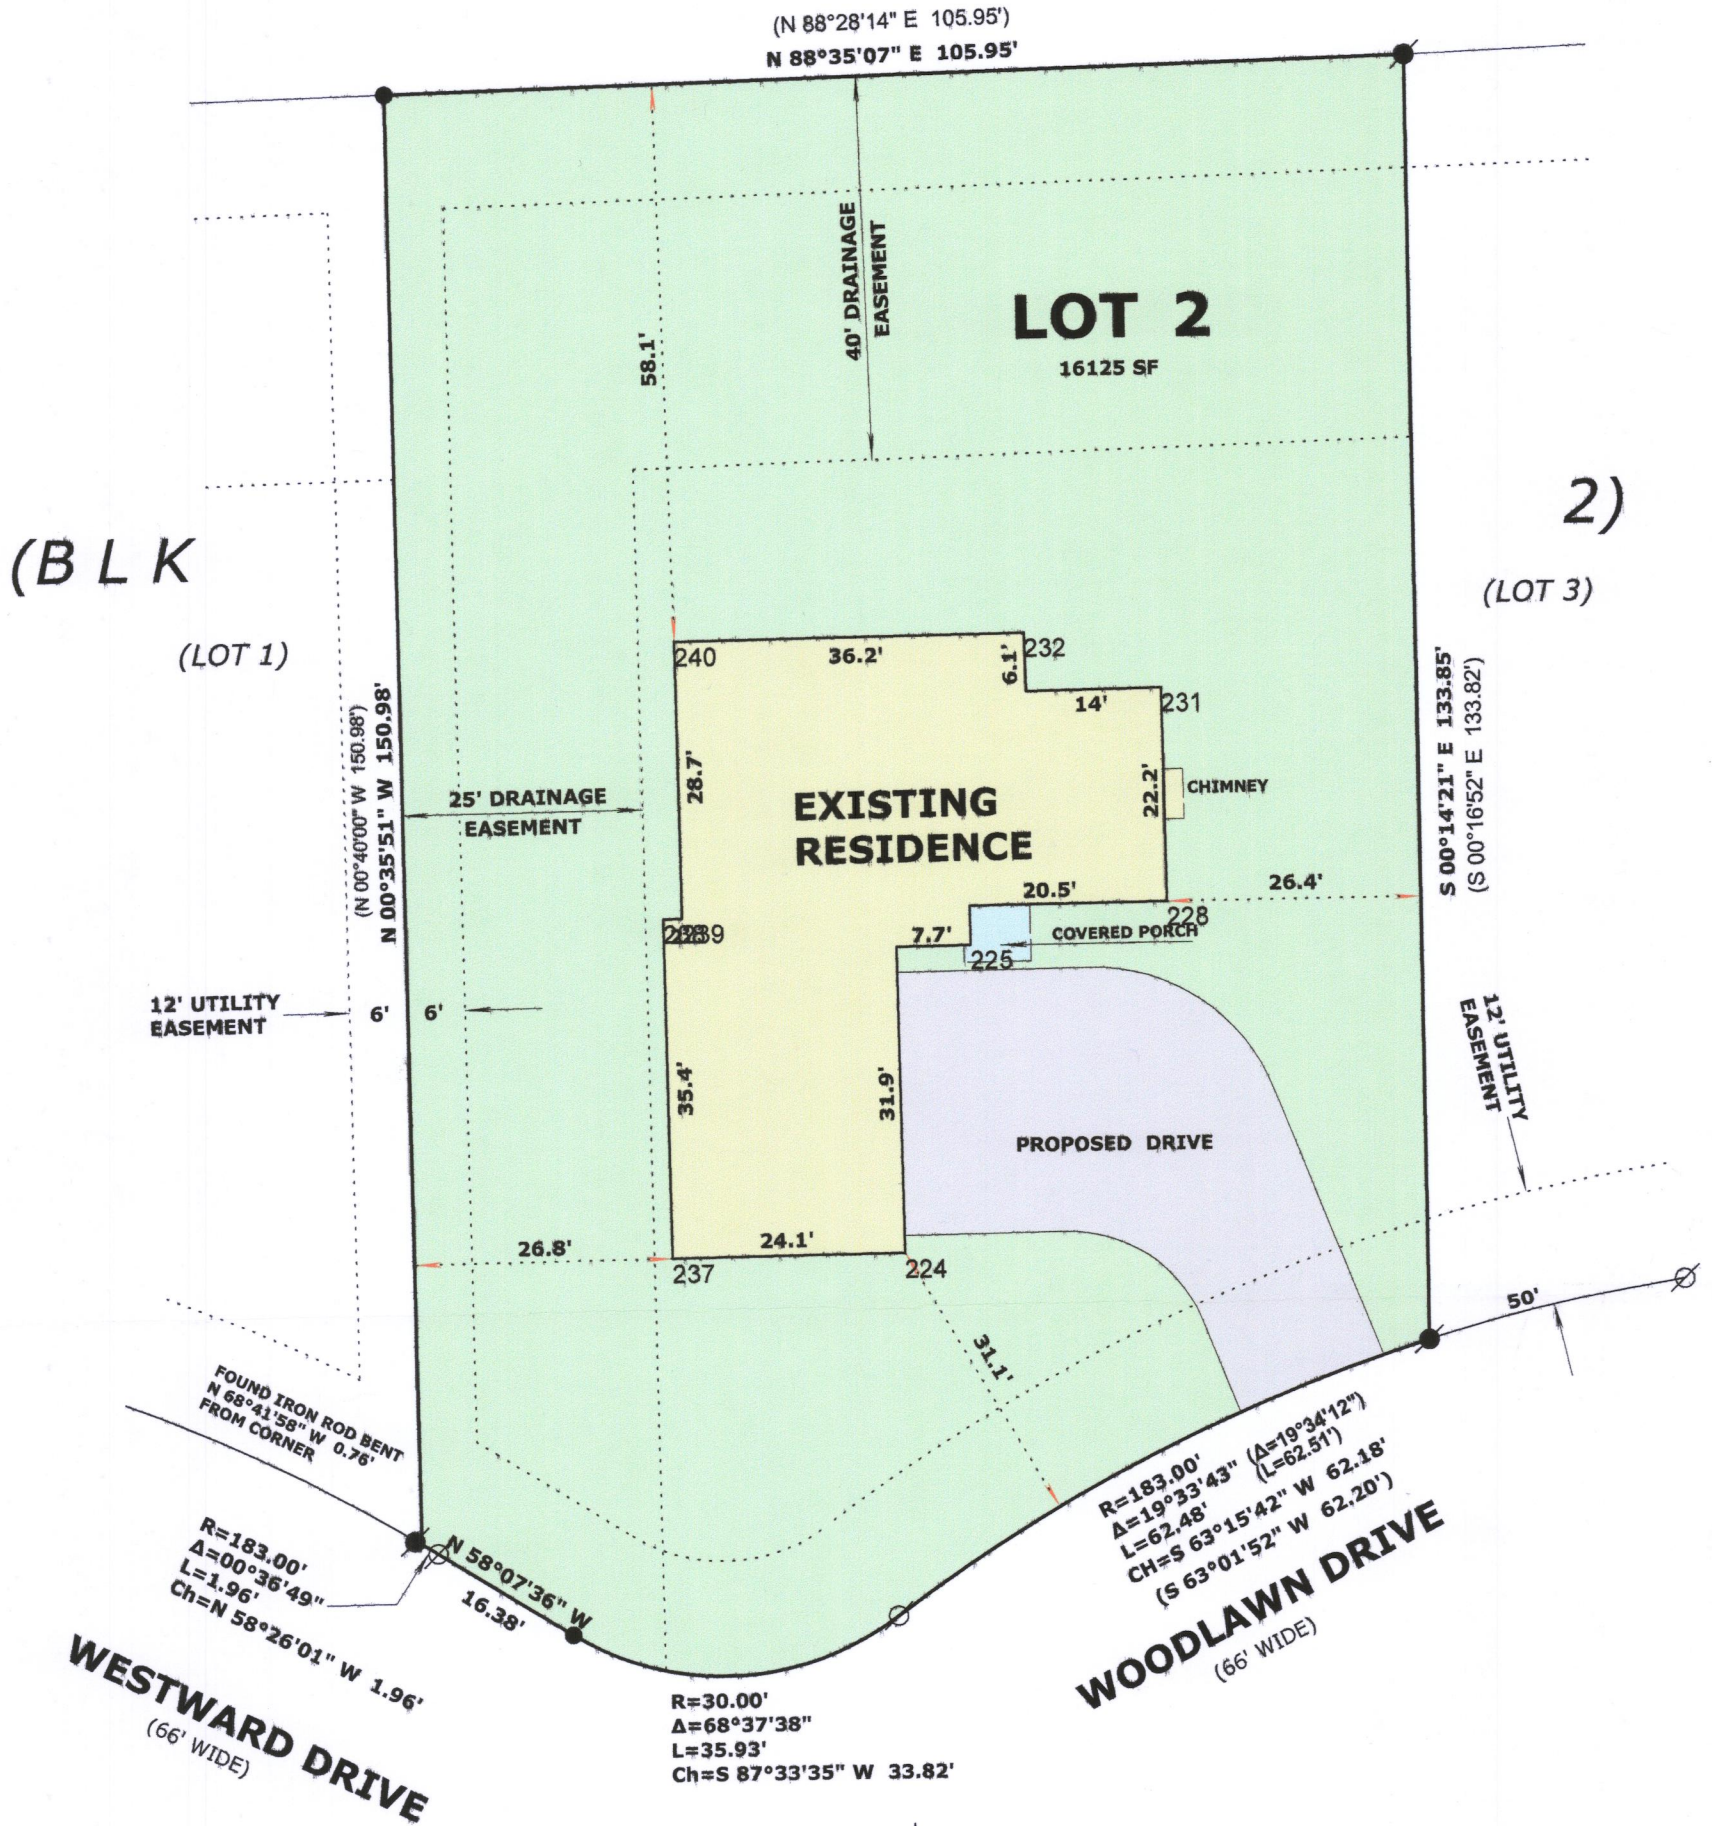

OWNER: GM-PC HOLDINGS, LLC  
PO Box 545  
Williams Bay, WI. 53191

BUILDER: Basso Builders Inc.  
405 Skyline Dr.  
Lake Geneva, WI 53147

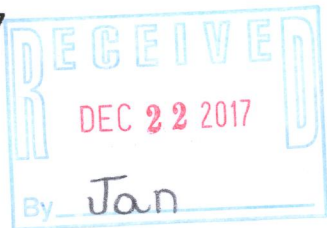

LEGAL DESCRIPTION

LOT 2, BLOCK 2 PRAIRIE VIEW SUBDIVISION  
REC. IN CAB. C, SLIDE 195, AS DOC. #623553

LOCATED IN THE NORTHWEST 1/4 OF THE NORTHEAST 1/4, SECTION 2,  
TOWNSHIP 1 NORTH, RANGE 16 EAST, IN THE VILLAGE OF WILLIAMS BAY,  
WALWORTH CO., WISCONSIN



LEGEND

- FOUND IRON ROD 1 5/16"
- FOUND IRON ROD 3/4"
- SET IRON ROD, 18" LONG, WEIGHING 1.5 LBS./LINEAL FT., 3/4" DIA.
- ( x x ) RECORDED AS DIMENSION

SCALE: 1 INCH = 20 FEET

"I hereby certify that the above described property has been surveyed by me or under my direction and that the above map is a true representation thereof and shows the size and location of the property, its exterior boundaries, the location of all visible structures and dimensions of all principal buildings thereon, boundary fences, apparent easements, roadways and visible encroachments, if any."  
"This survey is made for the use of the present owners of the property, and also those who purchase, mortgage, or guarantee the title thereto within one year from date hereof."

MARK L. MIRITZ  
WISCONSIN PROFESSIONAL  
LAND SURVEYOR S-2582  
DATE: APRIL 27, 2017 JOB NO. 17.413

REVISED NOVEMBER 8, 2017 TO  
SHOW RESIDENCE "AS BUILT"

WPV-28

011-2807