FARRIS, HANSEN & ASSOCIATES, INC.

ENGINEERING - ARCHITECTURE - SURVEYING
7 RIDGWAY COURT - P.O. BOX 437 - ELKHORN, WISCONSIN 53121
PHONE: (262) 723-2098 FAX: (262) 723-5886

PLAT OF SURVEY


LOT 91 OF BAILEY ESTATES

LOCATED IN PART OF THE NW 1/4 OF THE

NW 1/4 OF SECTION 36, TOWN 2 NORTH, RANGE 16 EAST,

VILLAGE OF WILLIAMS BAY, WALWORTH COUNTY, WISCONSIN

 WORK ORDERED BY –
 GERSTAD BUILDERS, INC
 2703 BUSH TERRACE McHENRY IL., 60051

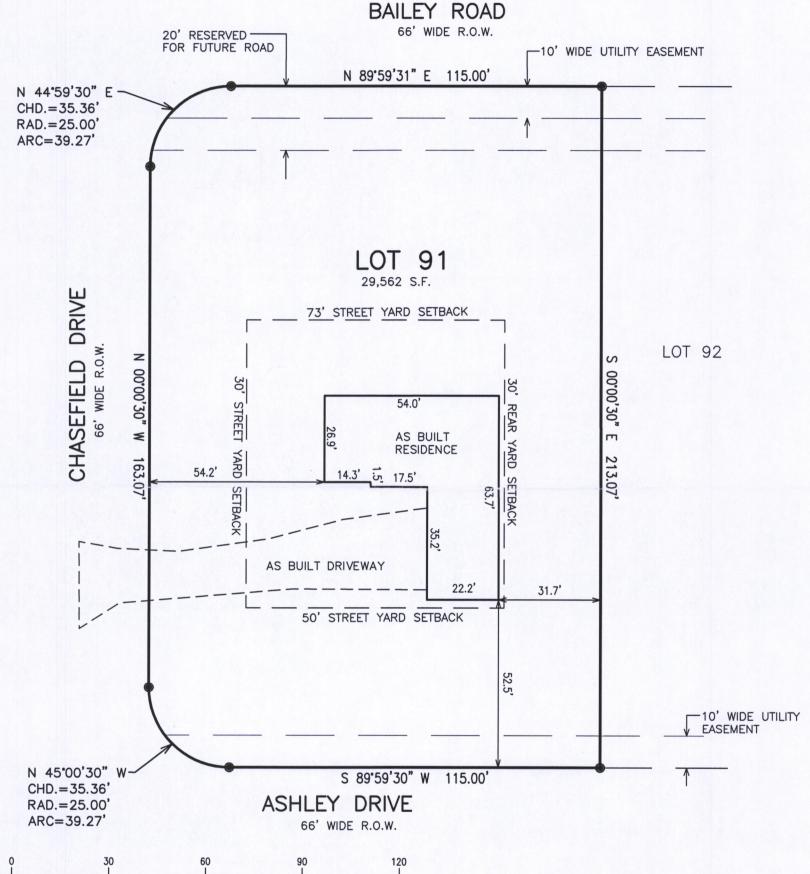

MAP SCALE IN FEET - ORIGINAL 1"=30'

NOTE: COPIES OF THIS MAP TO WHICH THE FOLLOWING CERTIFICATE WILL APPLY SHOW THE SURVEYOR'S ORIGINAL SEAL AND SIGNATURE IN RED INK. COPIES BY ANY OTHER MEANS MAY HAVE ALTERATIONS WHICH DO NOT REPRESENT THE SURVEYOR'S WORK PRODUCT.

I HEREBY CERTIFY THAT THE ABOVE DESCRIBED PROPERTY HAS BEEN SURVEYED UNDER MY DIRECTION AND THAT THE ABOVE MAP IS A TRUE REPRESENTATION

SCONSIA

BRIAN M.

CARLSON

S-2039 ROCKFORD,

LEGEND

= FOUND IRON REBAR STAKE

{XXX} = RECORDED AS

I HEREBY CERTIFY THAT THE ABOVE DESCRIBED PROPERTY HAS BEEN SURVEYED UNDER MY DIRECTION AND THAT THE ABOVE MAP IS A TRUE REPRESENTATION THEREOF AND SHOWS THE SIZE AND LOCATION OF THE PROPERTY AND ITS EXTERIOR BOUNDARIES. THIS SURVEY IS MADE FOR THE USE OF THE PRESENT OWNERS OF THE PROPERTY, AND ALSO THOSE WHO PURCHASE, MORTGAGE, OR GUARANTEE THE TITLE THERETO WITHIN ONE YEAR FROM THE DATE HEREOF.

DATED: 12/22/2005

REVISED 12/28/2017 TO SHOW SIZE AND LOCATION OF AS BUILT RESIDENCE

PROJECT: 3249.91

BRIAN M. CARLSON P.L.S. 2039

DATE: 12/22/2005
SHEET 1 OF 1