



PREPARED FOR  
HUMMEL  
CONSTRUCTION





# PLAT OF SURVEY

- OF -

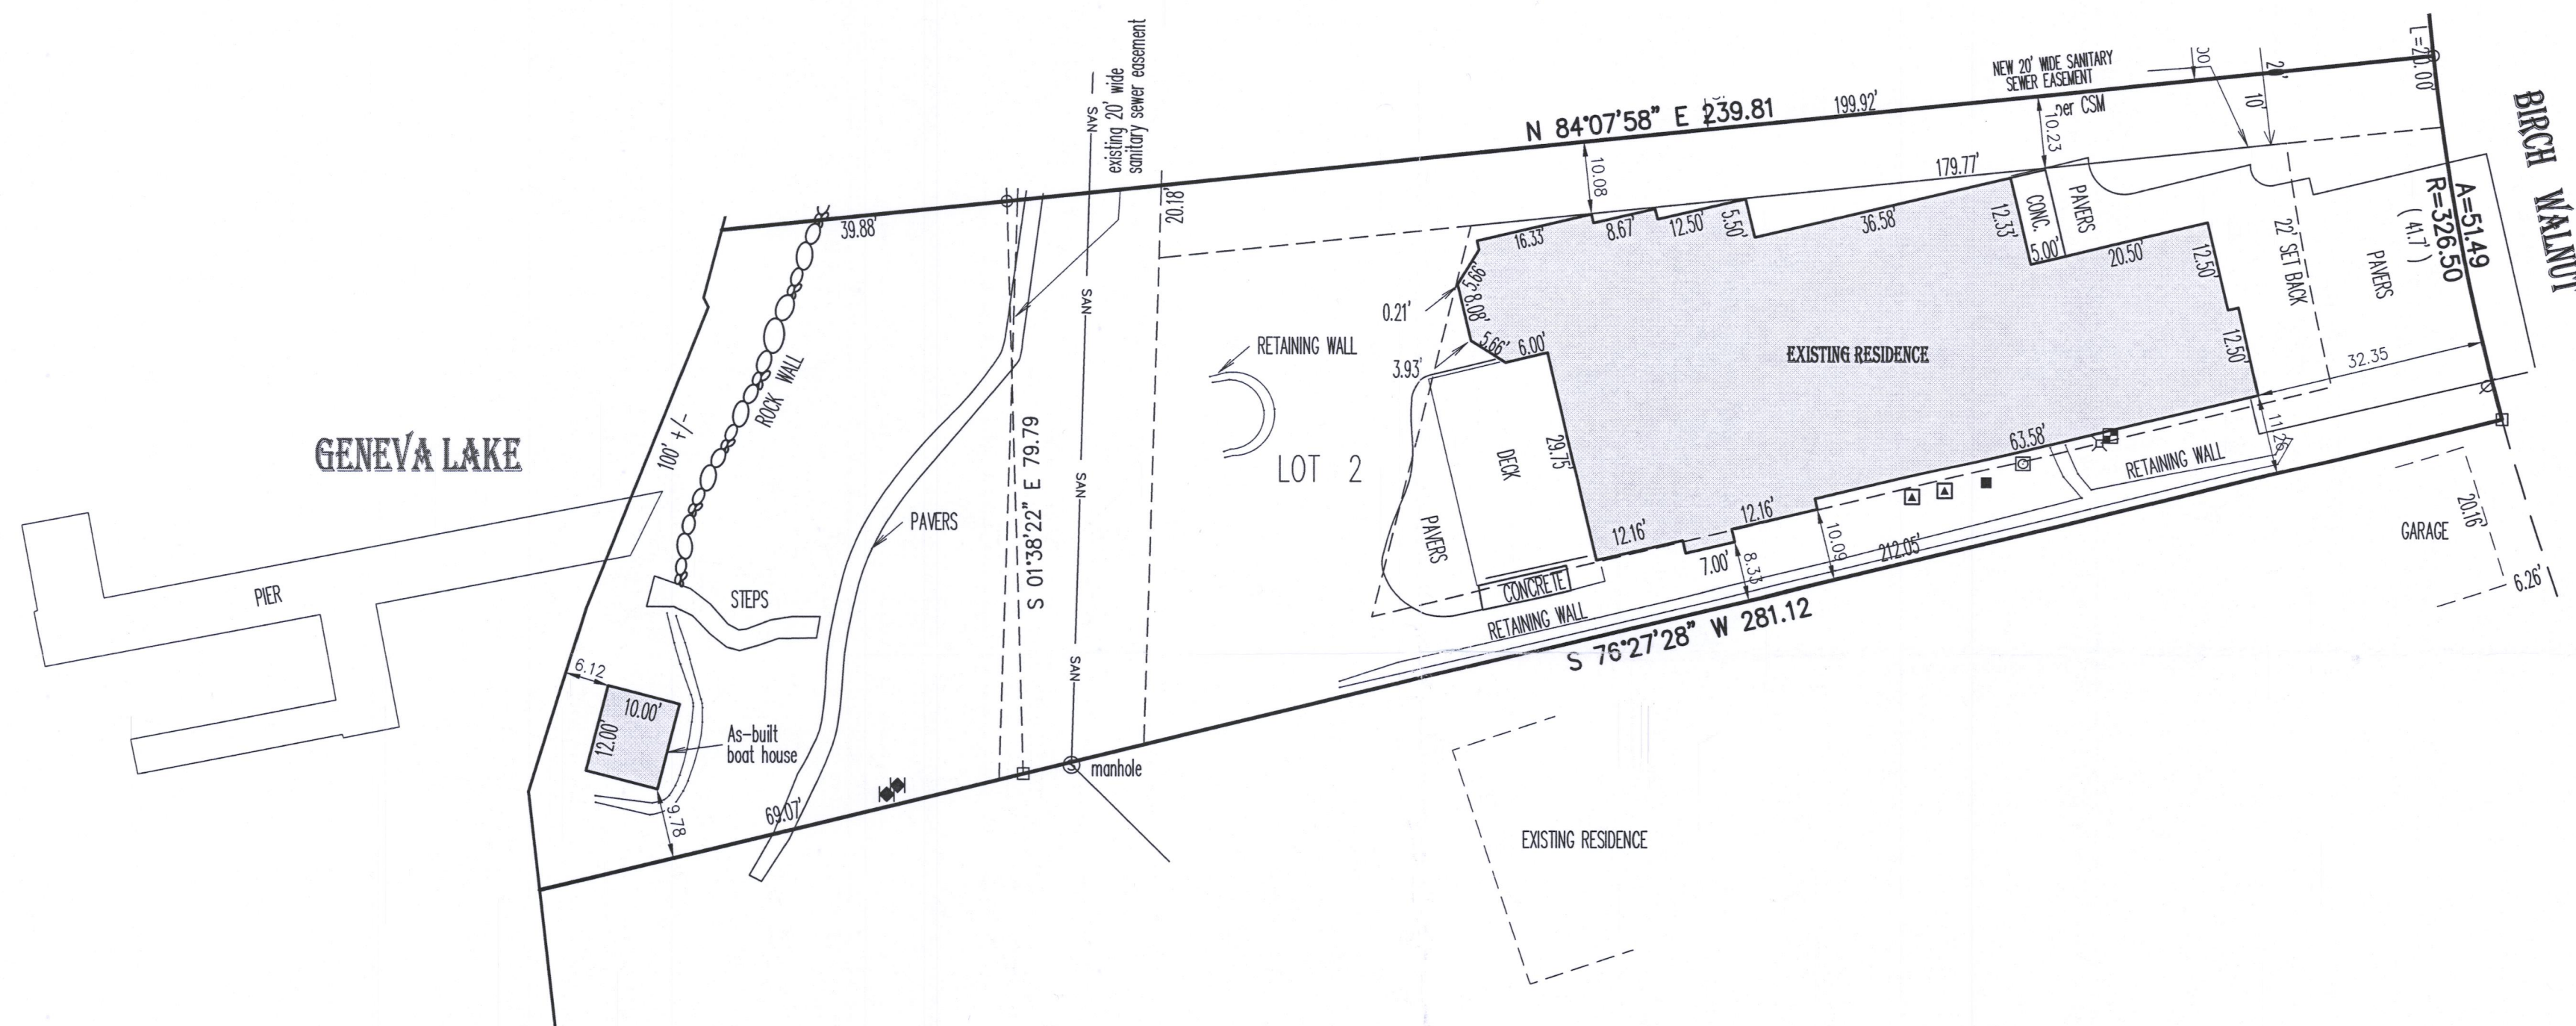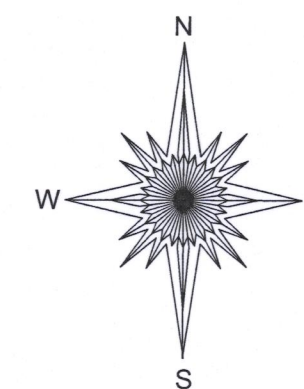LOT 2 WALWORTH COUNTY CERTIFIED SURVEY MAP No. 4693, BEING A  
REDIVISION OF THE SOUTH 1/2 OF LOT 33, LOTS 34 AND 35, CEDAR POINT  
PARK ADDITION NO. 1, LOCATED IN THE NORTHWEST 1/4 OF THE  
SOUTHEAST 1/4 OF SECTION 6, TOWNSHIP 1 NORTH, RANGE 17  
EASTVILLE OF WILLIAMS BAY, COUNTY OF WALWORTH AND STATE OF  
WISCONSIN.

PATHFINDER SURVEYING  
(a NMB Company)  
P.O BOX 322  
LAKE GENEVA, WI. 53147  
WWW.PATHFINDERSURVEYING.NET  
262-248-8303




- ( ) = recorded as  
 = power pole  
 ○ = found iron pipe  
 —OH— = overhead wires  
 □ = communication box  
 = sign  
 —CM— = communication line  
 ● = set 5/8" rebar  
 = yard light  
 = well  
 —X— = fence

SCALE 1" = 20'

JOB # 2017.0232.01

TAX ID # WA469300002

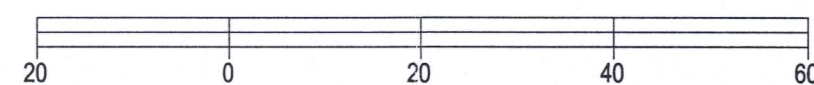


BASIS OF BEARING OF THIS PLAT: THE US STATE PLANE  
COORDINATE SYSTEM SOUTH ZONE, NAD 83, WISCORS.

I hereby certify that I have surveyed the above-described property and the above map is a true representation thereof and shows the size and location of the property, its exterior boundaries, the location and dimensions of all structures thereon, fences, apparent easements and roadways and visible encroachments if any.

This survey is made for the present owners of the property, and those who purchase, mortgage, or guarantee the title thereto, within one year from the date hereof.

DATED THIS 12TH DAY OF DECEMBER, 2017.

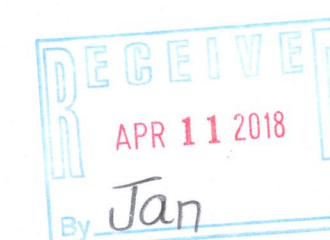

  
MARK R. MADSEN S - 2271  
Wisconsin Professional Land Surveyor

WA4693-2 011-2827