AMBIT LAND SURVEYING


8120-312th Avenue Wheatland, WI. 53105-8934 Licensed Professionals in both Illinois & Wisconsin

PLAT $OF_{OF}SURVEY$

Lot 15, Block 3, HARBOR VIEW SUBDIVISION, located in Section 6, Township 1 North, Range 17 East of the 4th Principal Meridian, Village of Williams Bay, Walworth County, Wisconsin.

Parcel Identification Number: WHV 00045

CEDAR POINT PARK

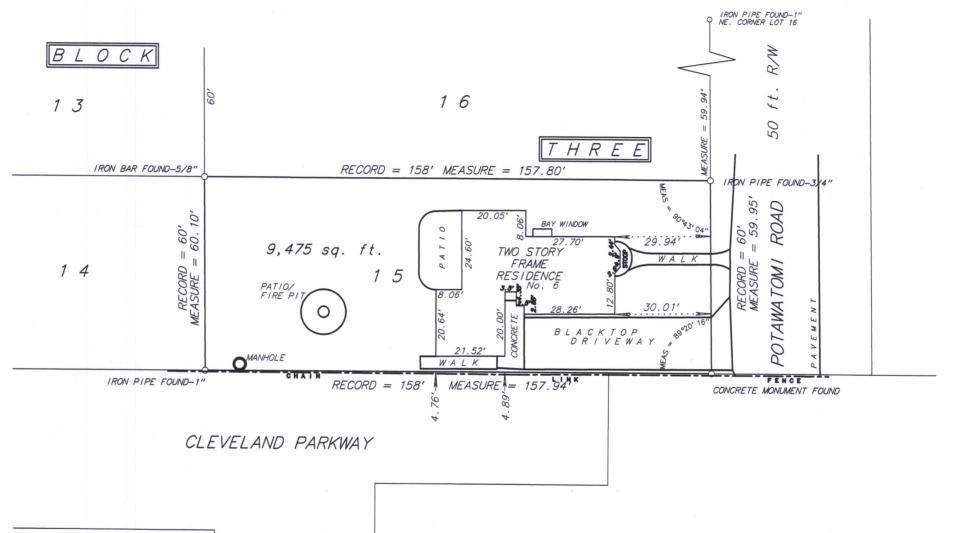

September 20, 2017 Fieldwork completed on and date of cert fi atin:

PHONE:

FAX:

EMAIL:

262-537-4874

262-537-4221

ambit@tds.net

I hereby certify that I have survived the above described property and the above plat is a true representation mere of and shows the size and location of the property, its exterior boundaries I the location and dimensions of all visible structures thereon, boundary less apparent easements and roadways and visible encroachments, if any

This survey is one fir the exclusive use of the present owners of the property, and also those who possesses, mortgage or guarantee the title thereto within ONE YEAR from the late hereof.

Dater as B ssett, Wisconsin this _____ day of ______ 2017.

Mark A. Bolender

Wisconsin Professional Land Surveyor - 1784



SCALE: 1 inch = 30 feet

ORDERED BY: M. Brennan/ @ Properties

JOB NO.: _____17201