## PREPARED FOR KEEFE REAL ESTATE


ORDERED BY LINDA TONGE

## PLAT OF SURVEY

- OF -

Lot 14 of Willabay Woods, a subdivision located in the Village of Williams Bay, Walworth County, Wisconsin.

PATHFINDER SURVEYING (a NMB Company) P.O BOX 322 LAKE GENEVA, WI. 53147 WWW.PATHFINDERSURVEYING.NET 262-248-8303

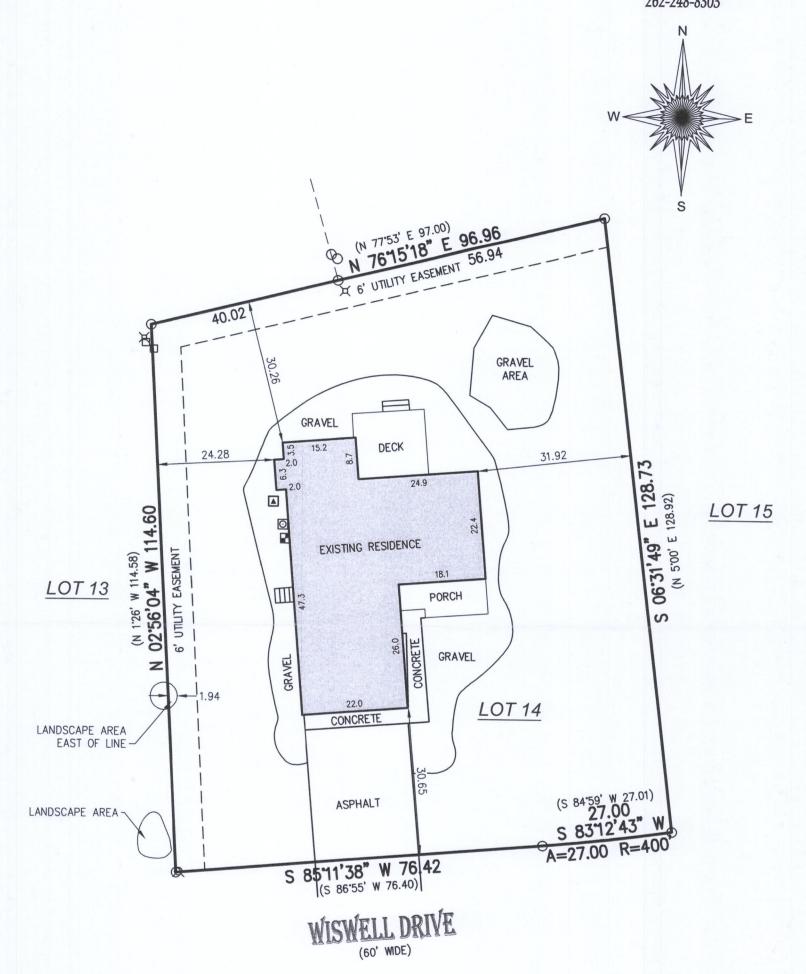

( ) = recorded as

= gas meter

= found iron pipe

= communication box

= electric pedestal


= electric meter

= hvac

SCALE 1" = 20'

JOB # 2018.0209.01

TAX ID # WUW 00014

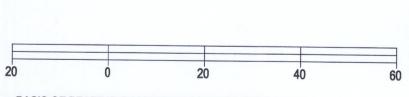

BASIS OF BEARING OF THIS PLAT: THE US STATE PLANE COORDINATE SYSTEM SOUTH ZONE, NAD 83. WISCORS.

I hereby certify that I have surveyed the above- described property and the above map is a is a true representation thereof and shows the size and location of the property, its exterior boundaries, the location and dimensions of all structures thereon, fences, apparent easements and roadways and visible encroachments if any to the best of my knowledge and belief.

This survey is made for the present owners of the property, and those who purchase, mortgage, or guarantee the title thereto, within one year from the date hereof.

DATED THIS 9TH DAY OF JULY, 2018.





Wisconsin Professional Land Surveyor