## PREPARED FOR MAURICIO CASTANEDA

## PLAT OF SURVEY

- OF -

LOT 8, BLOCK 8 OF PRAIRIE VIEW SUBDIVISION, RECORDED IN CABINET C, SLIDE 195 AS DOCUMENT N). 623223, LOCATED IN PART OF THE NW 1/4 AND NE 1/4 OF THE NE 1/4 OF SECTION 2, TOWN 1 NORTH, RANGE 16 EAST, VILLAGE OF WILLIAMS BAY, WALWORTH COUNTY, WISCONSIN.

PATHFINDER SURVEYING


(a NMB Company)

P.O BOX 322

LAKE GENEVA, WI. 53147

WWW.PATHFINDERSURVEYING.NET

262-248-8303

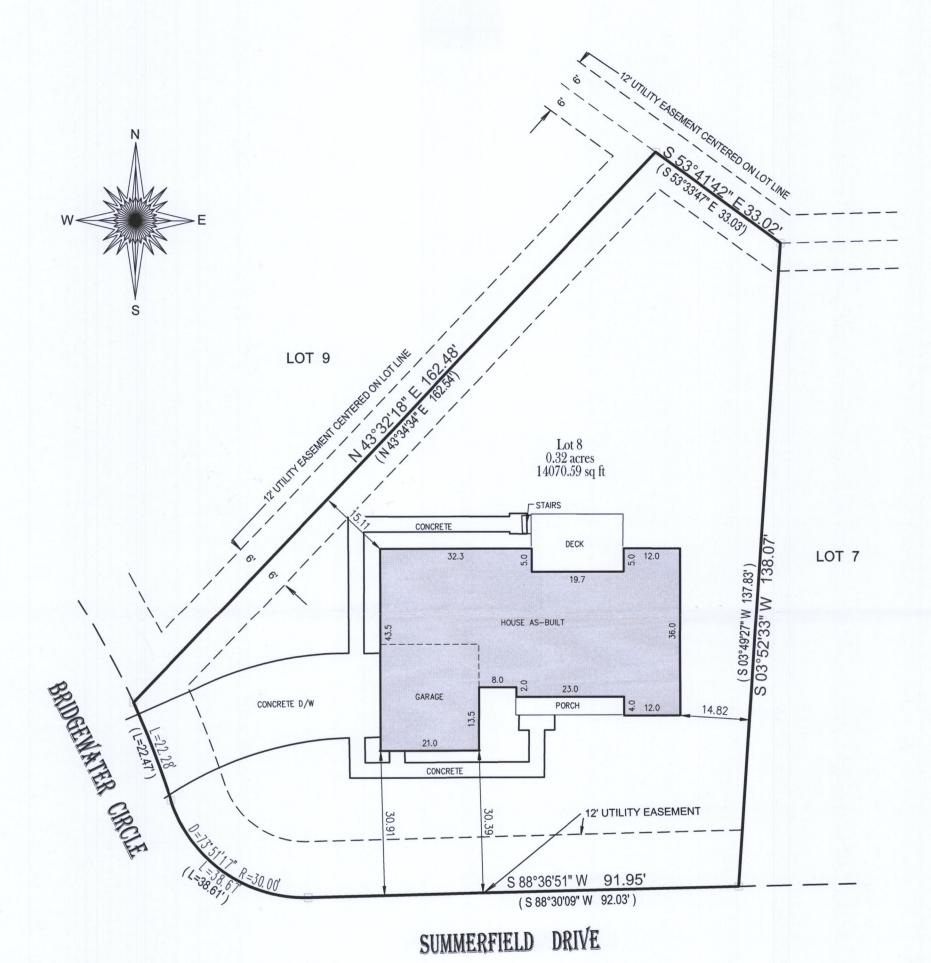



- □ = found iron bar
- = found iron pipe
- = set iron pipe
- = set iron bar

SCALE 1" = 20'

JOB # 2017.0197.01

TAX ID # WPV 00085



BASIS OF BEARING OF THIS PLAT: THE US STATE PLANE COORDINATE SYSTEM SOUTH ZONE, NAD 83. WISCORS.

I hereby certify that I have surveyed the above- described property and the above map is a is a true representation thereof and shows the size and location of the property, its exterior boundaries, the location and dimensions of all structures thereon, fences, apparent easements and roadways and visible encroachments if any.

This survey is made for the present owners of the property, and those who purchase, mortgage, or guarantee the title thereto, within one year from the date hereof.

DATED THIS 23RD DAY OF OCTOBER, 2018.





MARK R. MADSEN S - 2271 Wisconsin Professional Land Surveyor