

LEGEND

- IRON PIPE FOUND
- IRON ROD FOUND
- IRON PIPE SET 1 1/4" x 24"

SCALE: 1"=50' MAXIMUM POSITIONAL TOLERANCE=0.04'

DESCRIPTION:

LOTS 2 & 5 OF BLOCK 18 OF WILLIAMS 2ND ADDITION TO THE VILLAGE OF WILLIAMS BAY, WALWORTH COUNTY, WISCONSIN.


CERTIFICATE:

I, JOSEPH M. BIAGI, SURVEYOR, DO HEREBY CERTIFY THAT I HAVE SURVEYED THE LANDS HEREON DESCRIBED.

DATE:

APRIL 15, 1975

Joseph M. Biagi
 JOSEPH M. BIAGI SLS 12

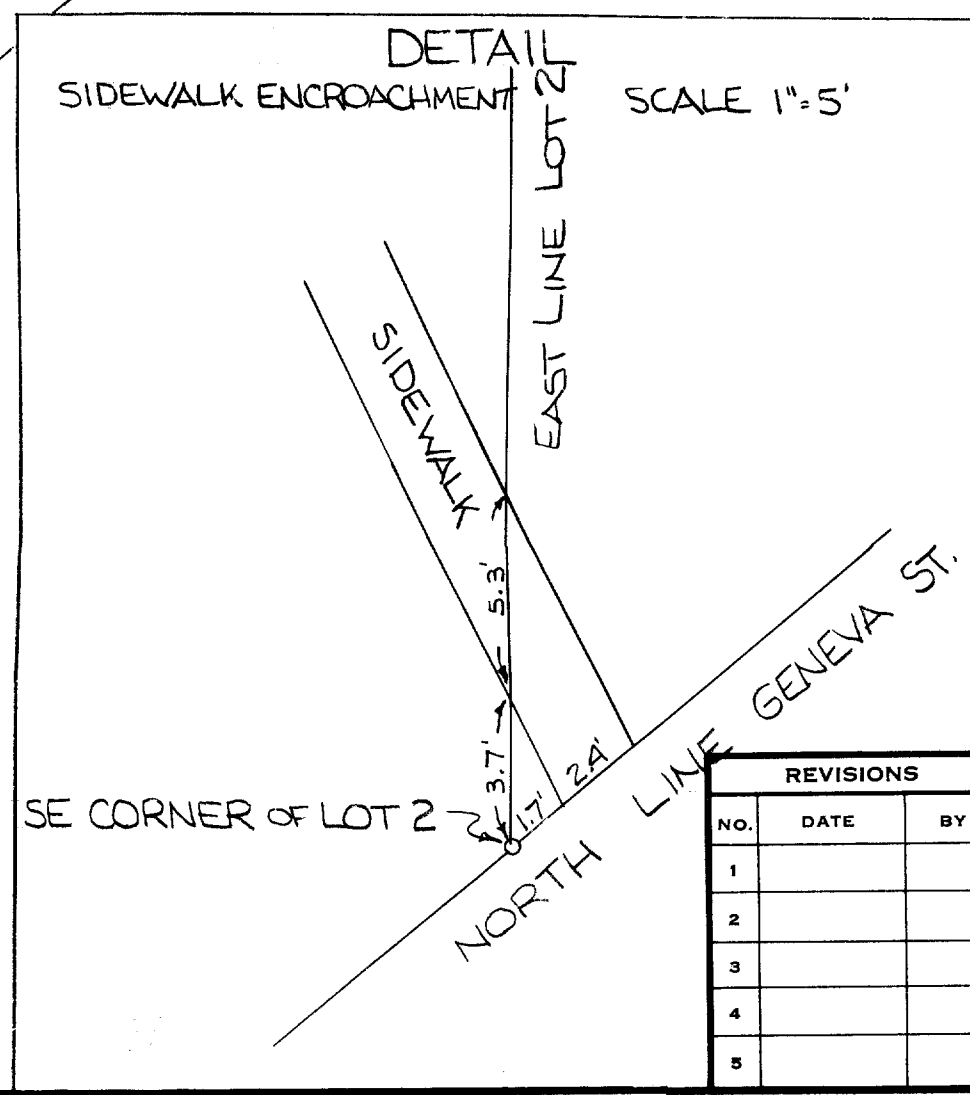

REVISIONS			T. ROBT. HORVATH (TRUSTEE)	
NO.	DATE	BY	LOTS 2 & 5 BLK 18 WMS 2 ND ADD.	
1				
2				
3			DRAWN BY GW	SCALE 1"=50'
4			CHK'D HG	DATE 4-15-75
5			TRACED	APP'D
			DRAWING NO. 42-75	