LAND-MARK SURVEYING


Mark L. Miritz Wisconsin Professional Land Surveyor S-2582

N9330 Knuteson Drive Whitewater, WI 53190 Phone: (262)495-3284 MarkMiritz@ Land-MarkSurveying.com

PLAT OF SURVEY

LOT 1 OF CERTIFIED SURVEY MAP NO. 4843

A REDIVISION OF LOTS 37, 38 AND 39, FIRST ADDITION TO CEDAR POINT PARK, LOCATED IN PART OF GOVERNMENT LOT 2 OF THE SOUTHEAST 1/4 OF SECTION 6, TOWN 1 NORTH, RANGE 17 EAST, VILLAGE OF WILLIAMS BAY, WALWORTH COUNTY, WISCONSIN.

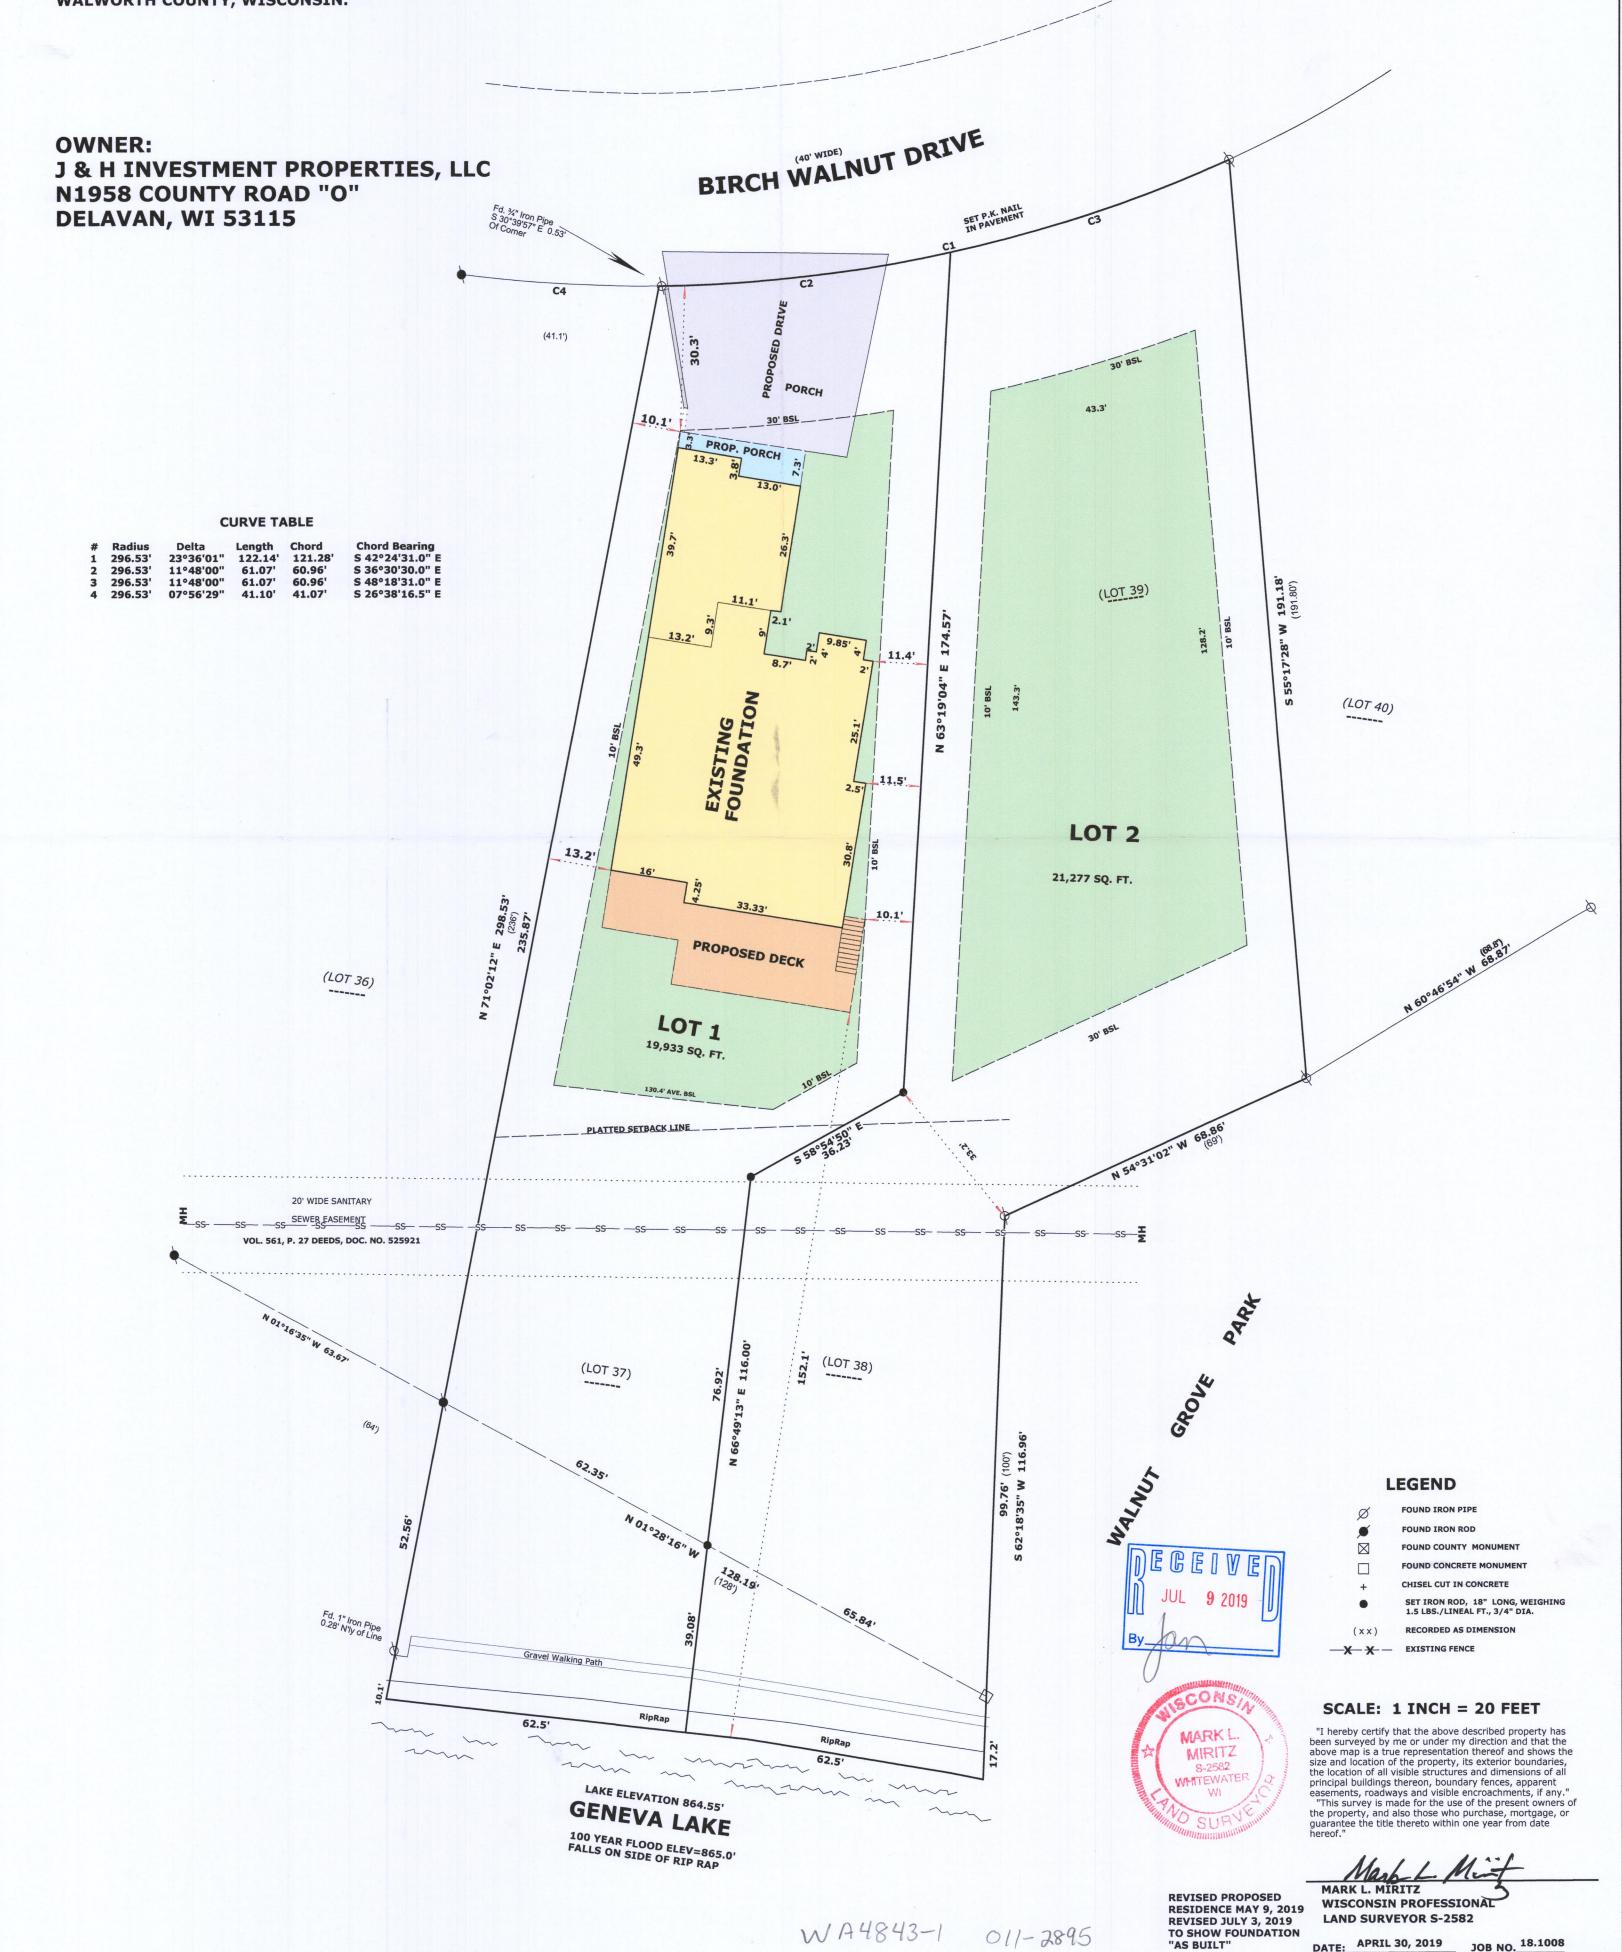

TO SHOW FOUNDATION

"AS BUILT"

DATE: APRIL 30, 2019 JOB NO. 18.1008