

# Plat of Survey

of


## Lot 51 of Willabay Woods,

a subdivision located in the Northeast 1/4 of the Northeast 1/4 of  
Section 6, Town 1 North, Range 17 East, Village of Williams Bay,  
Walworth County, Wisconsin.

Surveyed for: **Rick & Kathy Dasko**

521 Morgan Drive  
Williams Bay, Wisconsin. 53191

Bearings referenced to the South line of Morgan Drive,  
recorded as S89°25'E on the plat of Willabay Woods.

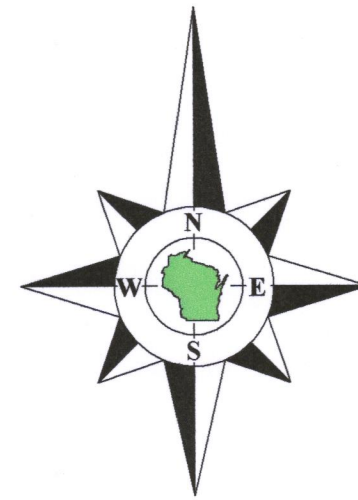

Survey Date: July 20, 2017.  
Revisions: No. 1 - Proposed Screen Addition  
No. 2 - Screen Addition  
No. 3 - Addition Complete

Scale in Feet  
1" = 20'  
0' 10' 20' 40' 60'

45 South Wisconsin Street | P.O. Box 322  
Elkhorn, Wisconsin. 53121  
Telephone: (262) 723-3434  
Facsimile: (262) 723-8044  
Email: doug@olsonsurveying.com  
Website: www.olsonsurveying.com

**OLSON**  
LAND SURVEYING, LLC  
Rural | Residential | Commercial

Legend of Symbols & Abbreviations  
N North  
S South  
E East  
W West  
in Degrees  
in Minutes  
in Seconds  
in Feet  
in Inches  
Found Iron Pipe, 1" dia. unless noted  
Set Iron Pipe, 1" dia.  
Recorded Information  
Manhole  
Culvert  
Asphalt Surface  
Concrete Surface  
Patio Blocks


Sheet 1 of 1 Sheets  
Drawing Name  
Job Reference Number  
2017.055

2017.055

### Morgan Drive


(60' Wide)

recorded as(S89°25'E 331.05')  
S89°25'00"E 331.08'

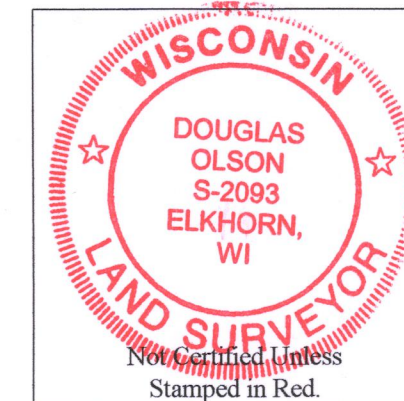

#### Notes:

- 1) This Plat of Survey is not certified unless signed and sealed in red ink.
- 2) This survey is subject to Wisconsin lien laws. This Plat of Survey is the notice of intent to file lien. Lien waiver required.
- 3) The Survey Date shown on this Plat of Survey is the completion date of the field work.

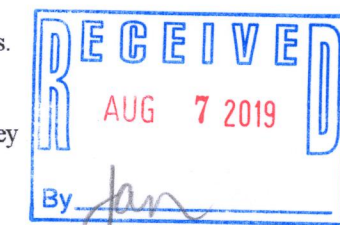

Copyright ©2017 by Olson Land Surveying, LLC.

All rights reserved. No part of this survey plat may be reproduced or transmitted in any form by any means - graphic, electronic, or mechanical, including photocopying, tracing, or information storage and retrieval systems - without permission in writing from Douglas G. Olson, Olson Land Surveying, LLC.

I hereby certify that I have surveyed the above described property in compliance with Chapter A-E 7 of the Wisconsin Administrative Code and that the map hereon is correct to the best of my professional knowledge and belief and shows the size and location of the property, its exterior boundaries, the location and dimensions of all visible structures thereon, boundary fences, apparent easements and roadways and visible encroachments, if any.

This survey is made for the exclusive use of the present owners of the property, and also those who purchase, mortgage or guarantee title thereto, within one year from the date hereof.

Douglas G. Olson  
Wisconsin Professional Land Surveyor - 2093

WUW-51 011-2904

Lot 52

Lot 11

Evangelical  
Free Church  
Subdivision

Hansen  
Street

### Bay View Avenue

(66' Wide)

**Lot 51**  
**Tax Parcel**  
**WUW 00051**  
0.346 Acre  
15,060 Sq.Ft.

**House**  
**No. 521**

N89°30'09"W 130.89'  
recorded as(N89°25'W 130.90')

S0°37'47"W 112.55'  
recorded as(S0°35'W 112.54')

Lot 50