
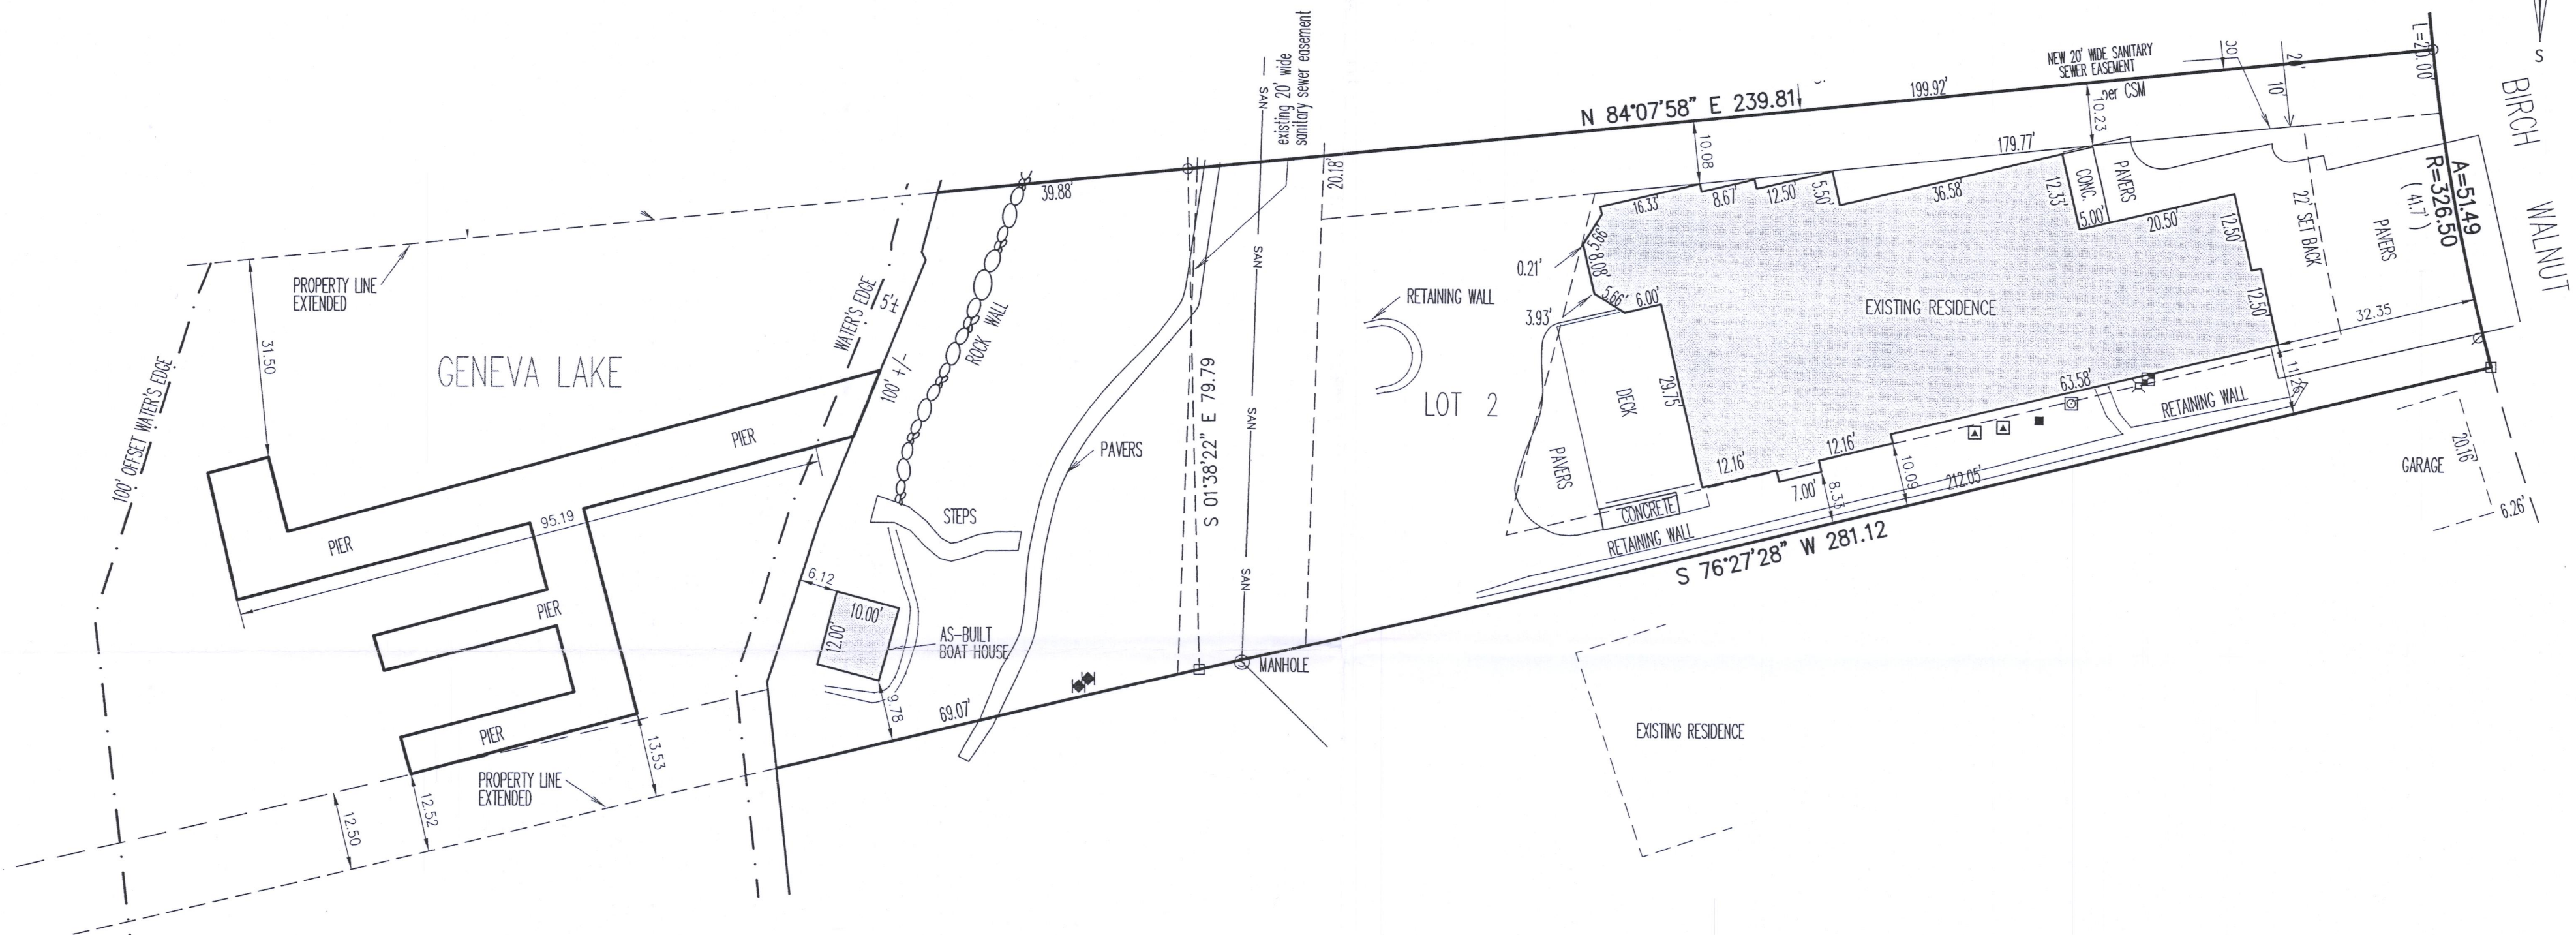


PREPARED FOR
HUMMEL
CONSTRUCTION


PLAT OF SURVEY

Lot 2 Walworth County Certified Survey Map No. 4693, being a
redivision of the South 1/2 of Lot 33. Lots 34 and 35, Cedar Point Park
Addition No. 1, located in the Northwest 1/4 of the Southeast 1/4 of
Section 6, Township 1 North, Range 17 East, Village of Williams Bay,
County of Walworth and State of Wisconsin.

PATHFINDER SURVEYING
(a NMB Company)
1458 HORIZON BLVD. STE. 200
RACINE, WI. 53406
WWW.PATHFINDERSURVEYING.NET
262-248-8303

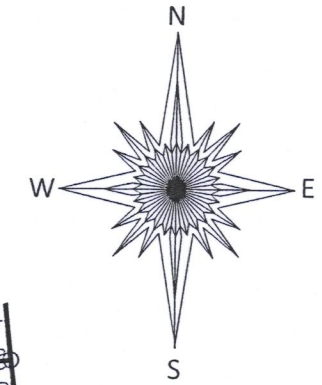

- () = recorded as
- ⊗ = power pole
- = found iron pipe
- SAN— = sanitary line
- = found iron bar
- ⊙ = sanitary manhole
- = electric meter
- ⊕ = gas meter
- ⊗ = electric pedestal
- ▲ = hvac
- ⊕ = water control valve
- = pad mount transformer

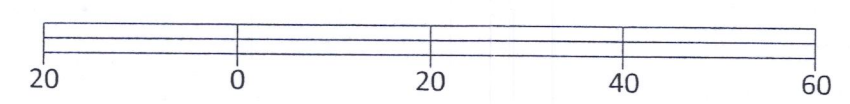


Basis of Bearing of this plat: The US State Plane
Coordinate System South Zone, NAD 83. WISCORS.

I hereby certify that I have surveyed the above- described
property and the above map is a true representation thereof
and shows the size and location of the property, its exterior
boundaries, the location and dimensions of all structures
thereon, fences, apparent easements and roadways and visible
encroachments, if any, to the best of my knowledge and belief.

This survey is made for the present owners of the property, and
those who purchase, mortgage, or guarantee the title thereto,
within one year from the date hereof.

Dated this 30th day of September, 2019.

SCALE 1" = 20'
JOB # 2017.0232.01
TAX ID # WA469300002

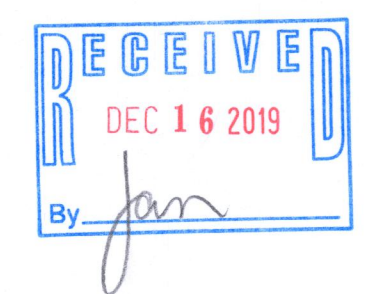

Mark R. Madsen
MARK R. MADSEN S - 2271
Wisconsin Professional Land Surveyor

WA4693-2 011-2925