
PLAT OF SURVEY


LOTS 29 AND 30 IN LOCH VISTA CLUB SUBDIVISION NO. 1, ACCORDING TO THE RECORDED PLAT THEREOF. SAID LAND BEING IN THE VILLAGE OF WILLIAMS BAY, COUNTY OF WALWORTH AND STATE OF WISCONSIN.

SURVEY FOR: JORNDT FAHEY BUILDERS, LLC

SURVEY ADDRESS: 181 CONFERENCE POINT ROAD, WILLIAMS BAY, WI 53191

20 P

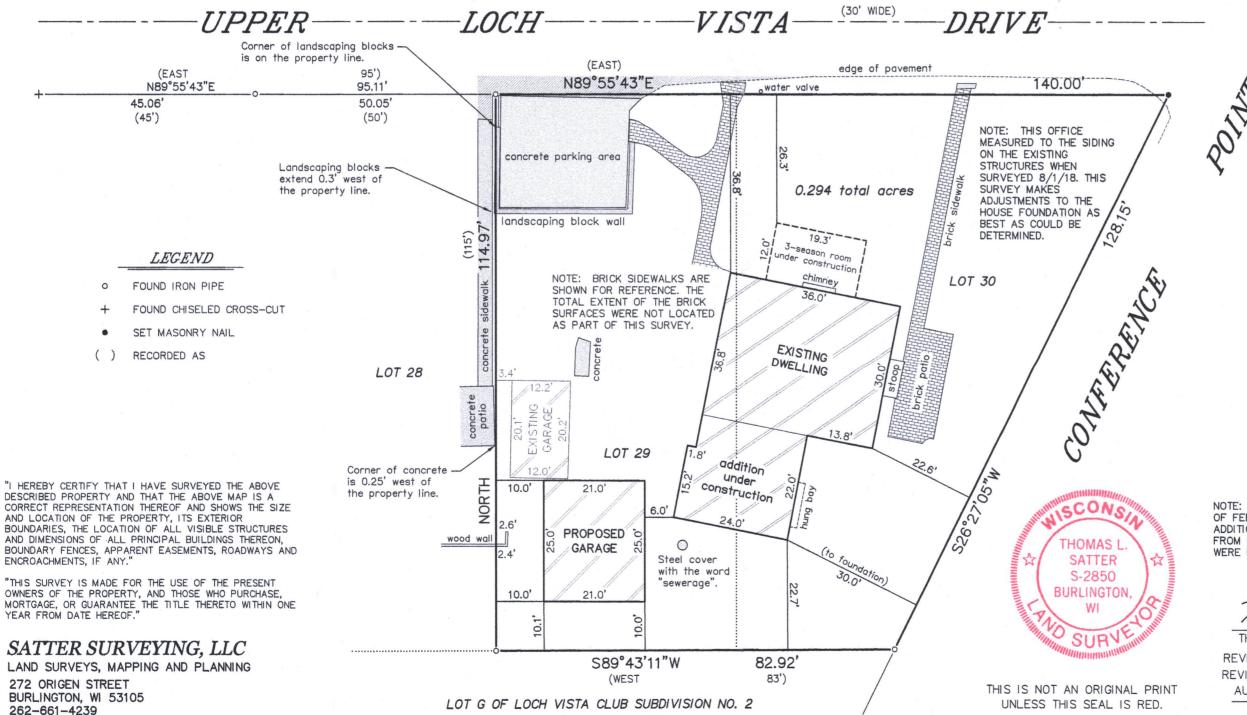

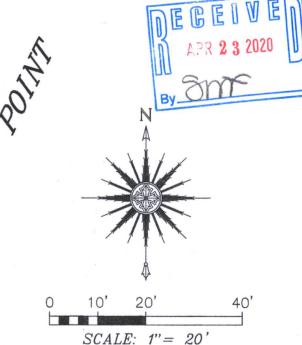

NOTE: THIS MAP IS BEING REVISED THIS 12TH DAY OF FEBRUARY, 2020 TO DEPICT THE EXISTING HOUSE ADDITIONS. ALL OTHER PROPERTY DETAILS ARE FROM PREVIOUS SURVEY WORK DATED 8/1/18 AND WERE NOT RE-VERIFIED AS PART OF THIS SURVEY.

RECORDED PLAT LEGAL DESCRIPTION).

BEARINGS HEREON RELATE TO THE WEST LINE OF LOT 29 OF LOCH VISTA CLUB SUBDIVISION NO. 1. ASSUMED BEARING OF NORTH AS PLATTED (PER

Thomas J. Scatter

THOMAS L. SATTER

S-2850

REVISED: 2/12/20 REVISED: 10/11/19

DATE

AUGUST 1, 2018

018 071803 JOB NUMBER