LAND-MARK SURVEYING

Mark L. Miritz

Wisconsin Professional Land Surveyor S-2582


N9330 Knuteson Drive Whitewater, WI 53190 Phone: (262)495-3284

MARKMIRITZ@ LAND-MARKSURVEYING.COM

PLAT OF SURVEY

LOT 16 OF BLOCK 7 OF THE ORIGINAL PLAT OF THE VILLAGE OF WILLIAMS BAY, LOCATED IN THE SOUTHEAST 1/4 OF THE NORTHEAST 1/4 OF SECTION 1, TOWN 1 NORTH, RANGE 16 EAST, AND THE SOUTHWEST 1/4 OF THE NORTHWEST 1/4 OF SECTION 6, TOWN 1 NORTH, RANGE 17 EAST, VILLAGE OF WILLIAMS BAY, WALWORTH COUNTY, WISCONSIN.

ORDERED BY: PREMIER HOMES P.O. BOX 100 WILLIAMS BAY, WI 53191

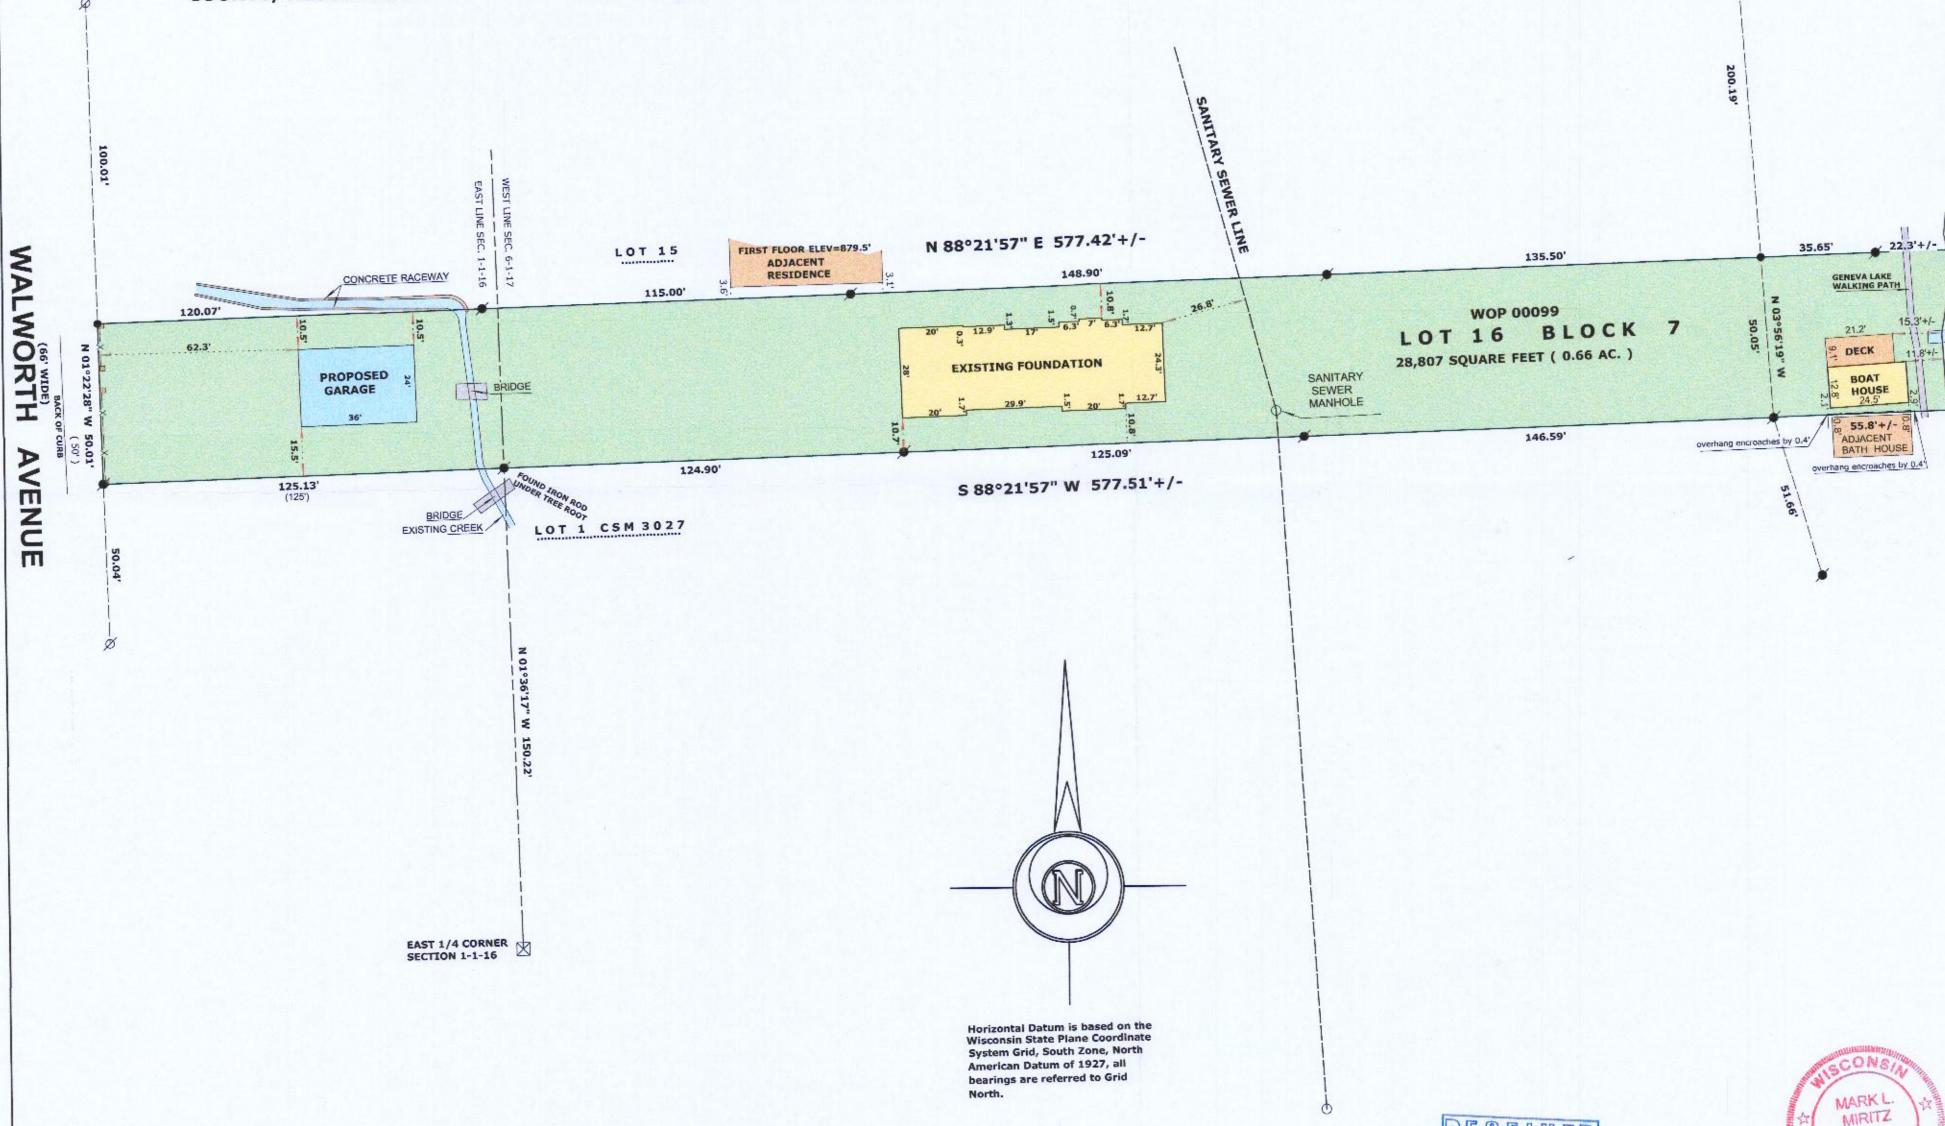

LEGEND

Ш

Z

m

不

Ш

FOUND IRON PIPE 1 1/4"

FOUND IRON ROD 3/4"

SET IRON ROD, 18" LONG, WEIGHING 1.5 LBS./LINEAL FT., 3/4" DIA.

(XX) RECORDED AS DIMENSION

-x- x- EXISTING WOOD FENCE

SCALE: 1 INCH= 30 FEET

"I hereby certify that the above described property has been surveyed by me or under my direction and that the above map is a true representation thereof and shows the size and location of the property, its exterior boundaries, the location of all visible structures and dimensions of all principal buildings thereon, boundary fences, apparent easements, roadways and visible encroachments, if any."

"This survey is made for the use of the present owners of the property, and also those who purchase, mortgage, or guarantee the title thereto within one year from date hereof."

WISCONSIN PROFESSIONAL

LAND SURVEYOR S-2582 DATE: SEPT. 20, 2018 JOB NO. 06.705

REVISED APRIL 11, 2020 TO SHOW FOUNDATION "AS BUILT" REVISED SEPT. 19, 2019 TO SHOW PROPOSED GARAGE & RESIDENCE

S-2582 WHITEWATER,