


FOUNDATION AS-BUILT

A PARCEL OF LAND LOCATED IN THE SOUTHEAST 1/4 OF THE NORTHWEST 1/4 OF SECTION 6 IN TOWNSHIP 1 NORTH, RANGE 17 EAST, IN THE VILLAGE OF WILLIAMS BAY, WALWORTH COUNTY, WISCONSIN.

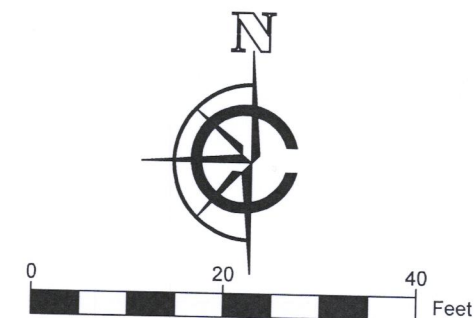

SCALE: 1"=20'


NOTE:

1. BASIS OF BEARING: THE WISCONSIN STATE PLANE COORDINATE SYSTEM, NAD-83, SOUTH ZONE.
2. FIELD WORK COMPLETED OCTOBER 15, 2020
3. BUILDING SURVEYED TO THE EXTERIOR OF SIDING.
4. FIELD CREW CHIEF: LOGAN RANDLE

LEGAL DESCRIPTION:

A PARCEL OF LAND LOCATED IN THE SOUTHEAST 1/4 OF THE NORTHWEST 1/4 OF SECTION 6 IN TOWNSHIP 1 NORTH, RANGE 17 EAST, IN THE VILLAGE OF WILLIAMS BAY, WALWORTH COUNTY, WISCONSIN, MORE PARTICULARLY DESCRIBED AS:

LOTS 1 AND 2 OF BLOCK 3 OF THE HARBOR VIEW SUBDIVISION, AS
RECORDED IN DOCUMENT # P247077 AT THE WALWORTH COUNTY REGISTER
OF DEEDS.

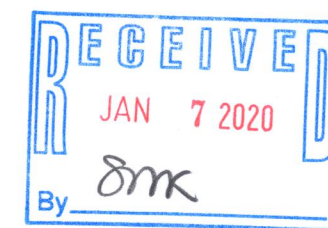

SURVEY ORDERED BY:


JOSEPH BALSITIS

PROPERTY ADDRESS:

647 E GENEVA ST
WILLIAMS BAY, WI 53191

SURVEYOR:

PAUL H. VAN HENKELUM, PLS
CARDINAL ENGINEERING LLC

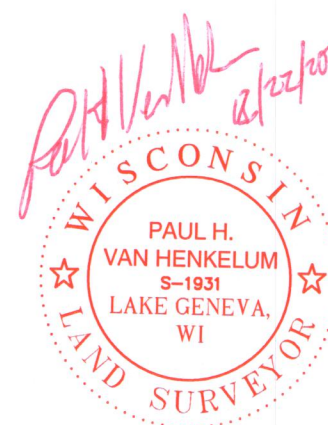












CARDINAL ENGINEERING LLC
DESIGNING IN TRUE DIRECTIONS

PO BOX 281 - 1200 LA SALLE ST.
LAKE GENEVA, WI 53147
262-757-8776
CARDINALEENGINEERINGWI.COM



DATE: 12/22/2020 JOB No. 20486-C
SHEET 1 OF 1 JDB

- | | |
|---|--------------------|
|  | FOUND 1" IRON PIPE |
|  | SET 1" IRON PIPE |
|  | RECORDED AS |
|  | EXISTING CONCRETE |
|  | EXISTING BUILDING |
|  | CATCH BASIN |
|  | SANITARY MANHOLE |
|  | UTILITY PEDESTAL |
|  | POWER POLE |
|  | GAS BOX |

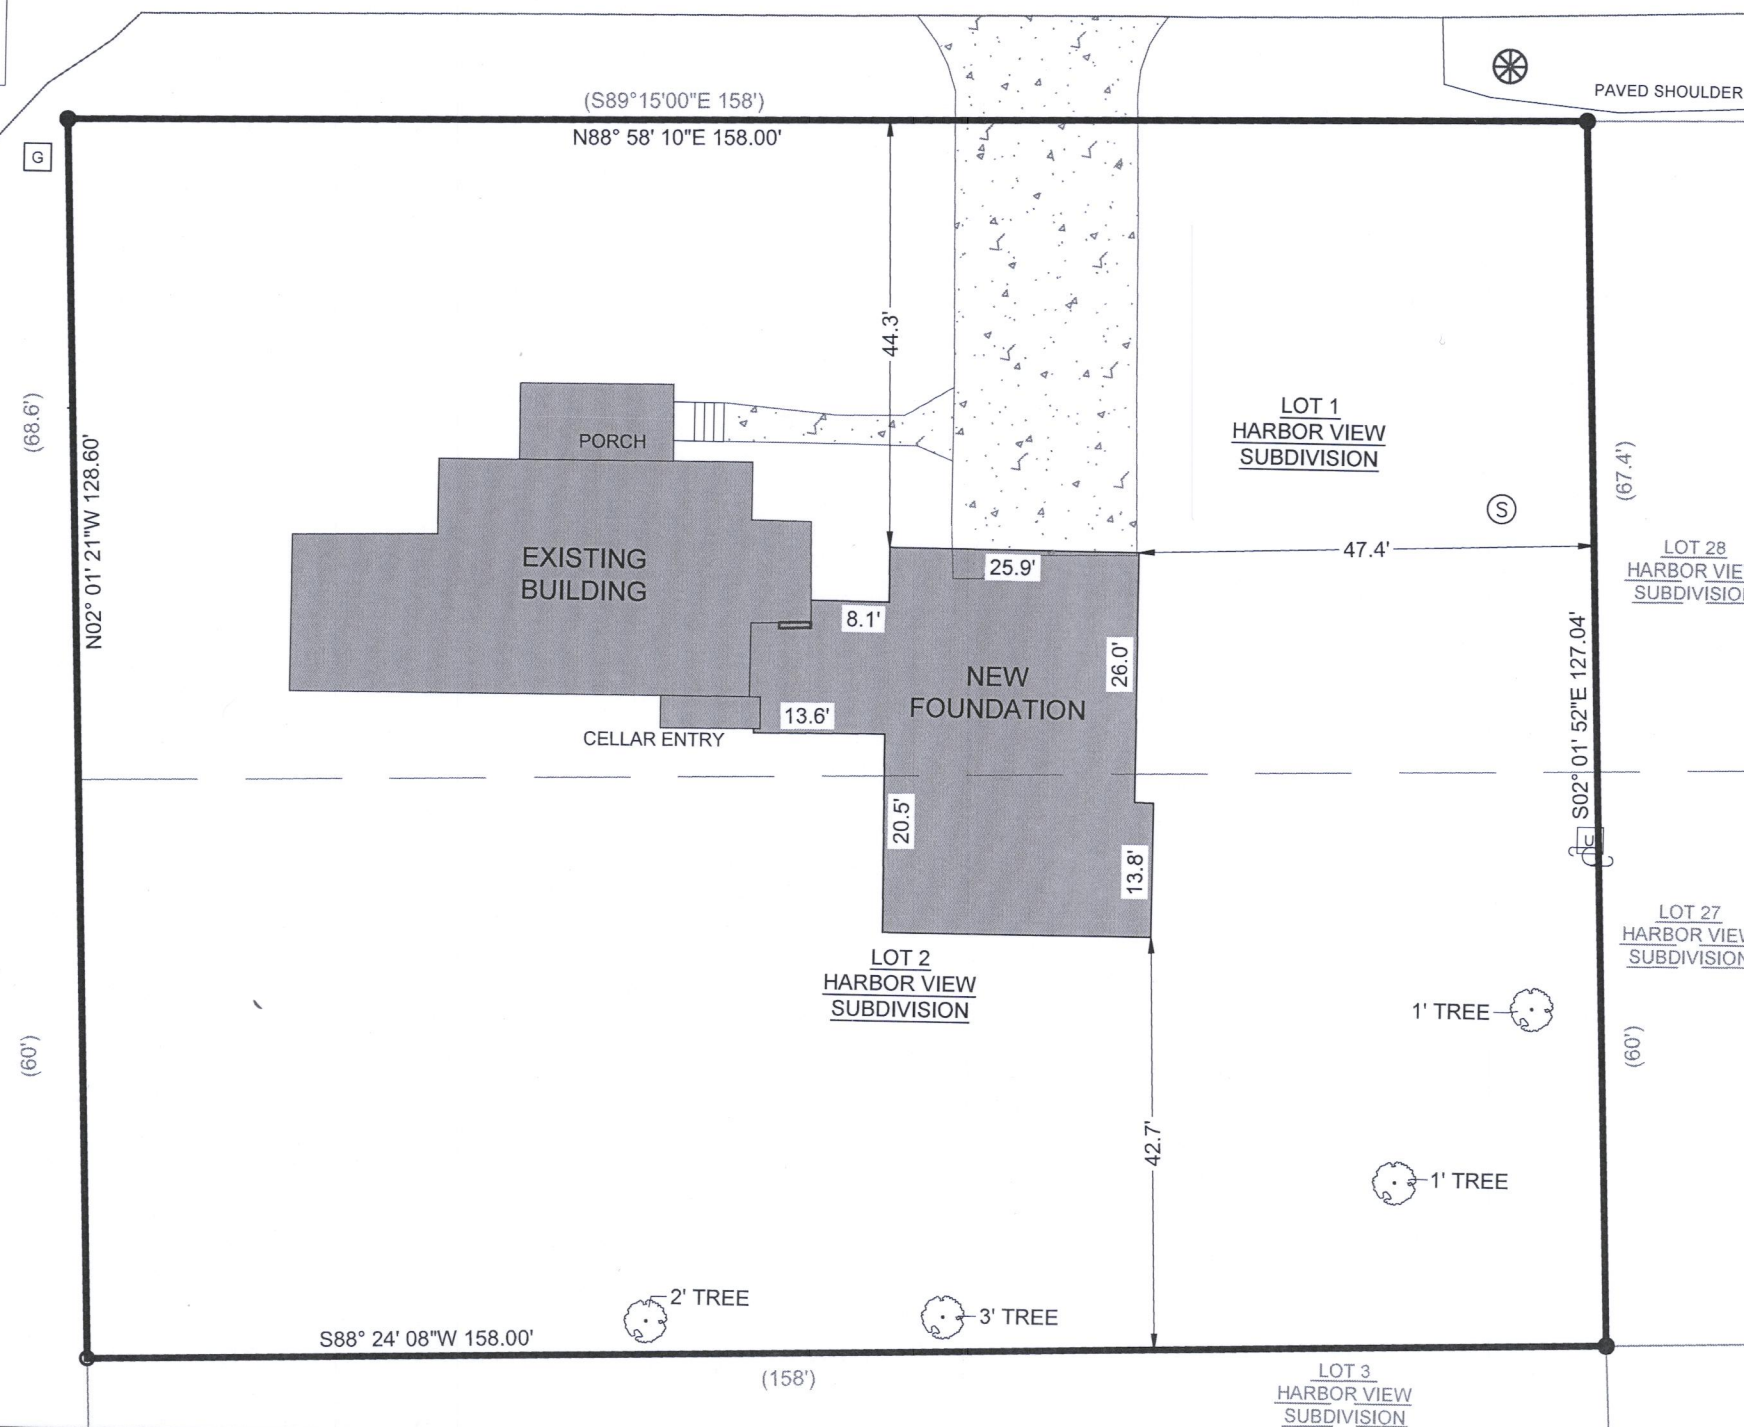

WHV-35