## LAND-MARK SURVEYING

Mark L. Miritz Wisconsin Professional Land Surveyor S-2582


N9330 Knuteson Drive Whitewater, WI 53190 Phone:(262)949-1239 MARKMIRITZ@ LAND-MARKSURVEYING.COM

SURVEY

LOT 2 AND LOT 3 OF BLOCK 13 OF WILLIAMS SECOND ADDITION TO THE VILLAGE OF WILLIAMS BAY, LOCATED IN THE SOUTHWEST 1/4 OF THE NORTHEAST 1/4 OF SECTION 1, TOWN 1 NORTH, RANGE 16 EAST, VILLAGE OF WILLIAMS BAY, WALWORTH COUNTY, WISCONSIN.

ORDERED BY: STACEY SCHULTZ **KEEFE REAL ESTATE 751 GENEVA PARKWAY** LAKE GENEVA, WI 53147

## **CHERRY STREET**

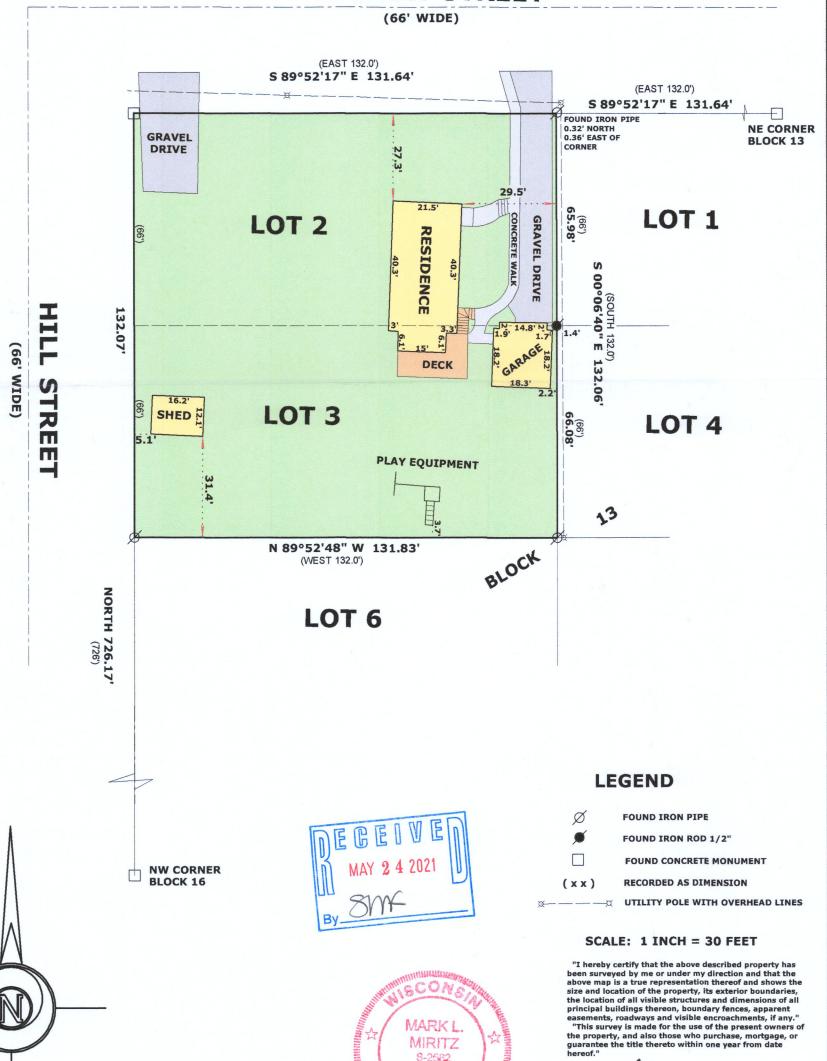

MIRITZ S-2582 WHITEWATER WI

SUR

Manumum

WOP - 188

EAST LINE HILL ST. ASSUME NORTH AS PLATTED

WISCONSIN PROFESSIONAL

JOB NO. 21.414

**LAND SURVEYOR S-2582 APRIL 30, 2021** 

MARK L. MIRITZ