

FARRIS, HANSEN & ASSOCIATES, INC.


ENGINEERING - ARCHITECTURE - SURVEYING
 7 RIDGWAY COURT - P.O. BOX 437 - ELKHORN, WISCONSIN 53121
 PHONE: (262) 723-2098 FAX: (262) 723-5886

PLAT OF SURVEY - AS BUILT

LOT 10 OF BAILEY ESTATES
 LOCATED IN PART OF THE NW 1/4 OF THE NW 1/4
 OF SECTION 36, TOWN 2 NORTH, RANGE 16 EAST,
 VILLAGE OF WILLIAMS BAY, WALWORTH COUNTY, WISCONSIN

- WORK ORDERED BY -
 GERSTAD BUILDERS
 2703 BUSH TERRACE
 McHENRY, IL 60051

WISCONSIN STATE PLANE COORDINATE SYSTEM
 ROTATE BEARINGS -01° 01' 12" FOR SOUTH ZONE BEARINGS
 NORTH LINE OF THE NW 1/4 OF SECTION 36
 N 00°00'00" E

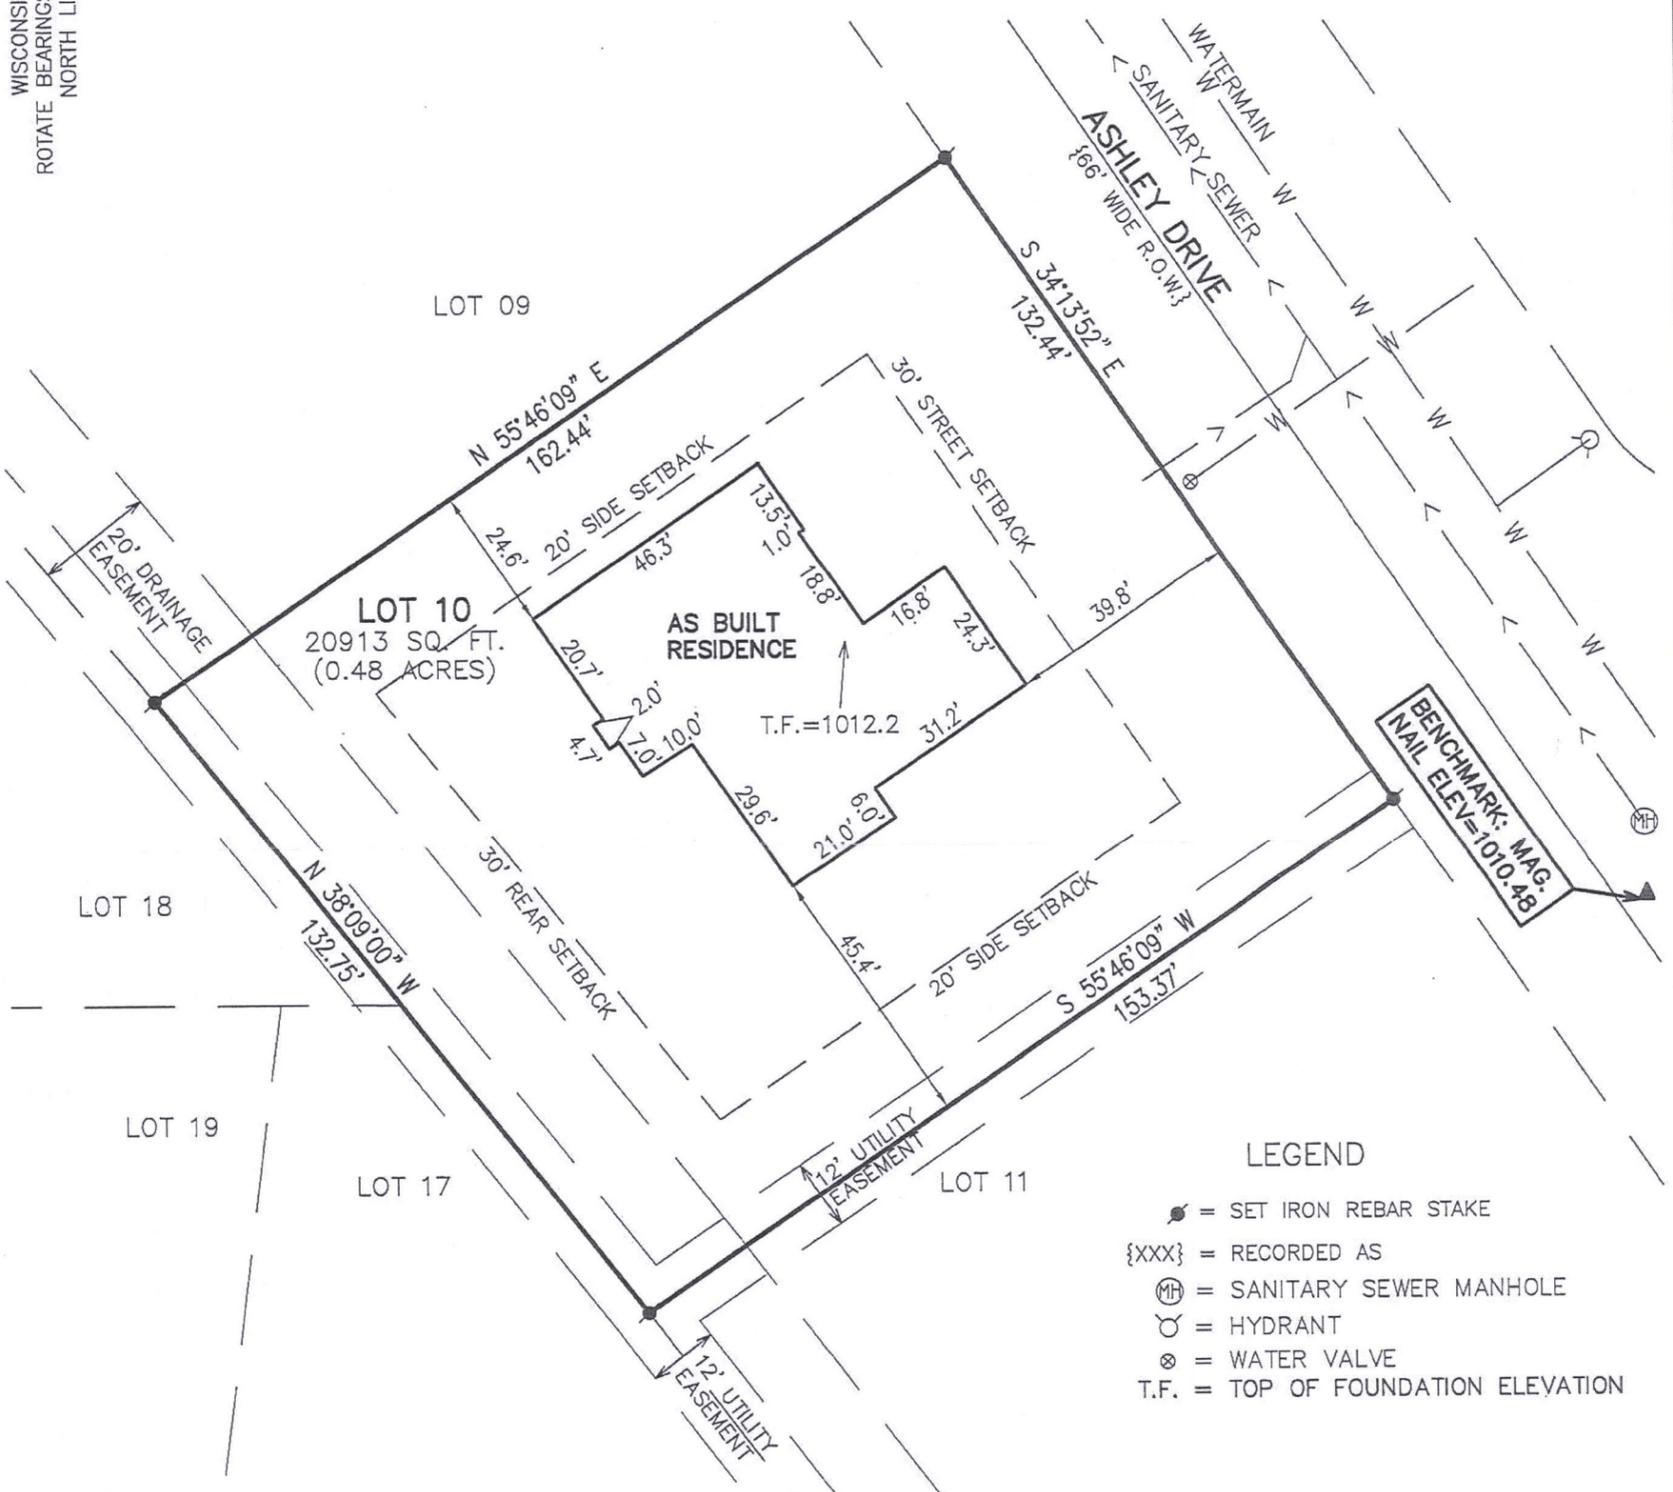

LEGEND

- = SET IRON REBAR STAKE
- {XXX} = RECORDED AS
- ⊕ = SANITARY SEWER MANHOLE
- ⊙ = HYDRANT
- ⊗ = WATER VALVE
- T.F. = TOP OF FOUNDATION ELEVATION



NOTE: COPIES OF THIS MAP TO WHICH THE FOLLOWING CERTIFICATE WILL APPLY SHOW THE SURVEYOR'S ORIGINAL SEAL AND SIGNATURE IN RED INK. COPIES BY ANY OTHER MEANS MAY HAVE ALTERATIONS WHICH DO NOT REPRESENT THE SURVEYOR'S WORK PRODUCT.

I HEREBY CERTIFY THAT THE ABOVE DESCRIBED PROPERTY HAS BEEN SURVEYED UNDER MY DIRECTION AND THAT THE ABOVE MAP IS A TRUE REPRESENTATION THEREOF AND SHOWS THE SIZE AND LOCATION OF THE PROPERTY AND ITS EXTERIOR BOUNDARIES. THIS SURVEY IS MADE FOR THE USE OF THE PRESENT OWNERS OF THE PROPERTY, AND ALSO THOSE WHO PURCHASE, MORTGAGE, OR GUARANTEE THE TITLE THERETO WITHIN ONE YEAR FROM THE DATE HEREOF.

DATED: 12/23/2019

BMC
 BRIAN M. CARLSON P.L.S. 2039



PROJECT: 3249.10
 DATE: 06/21/2017
 SHEET 1 OF 1

X:\PROJECTS\3249\INDIV_LOTS\LOT_10\ACAD\3249-10.DWG

WBAIL-10

011-3076