


ENGINEERING – ARCHITECTURE – SURVEYING
7 RIDGWAY COURT – P.O. BOX 437 – ELKHORN, WISCONSIN 53121
PHONE: (262) 723–2098 FAX: (262) 723–5886

PLAT OF SURVEY - AS BUILT

LOT 184 OF BAILEY ESTATES, A SUBDIVISION LOCATED IN PART OF THE SW 1/4 OF THE NW 1/4 OF SECTION 36, TOWN 2 NORTH, RANGE 16 EAST, VILLAGE OF WILLIAMS BAY, WALWORTH COUNTY, WISCONSIN

WORK ORDERED BY –
 GERSTAD BUILDERS
 2703 BUSH TERRACE
 MC HENRY, IL 60051

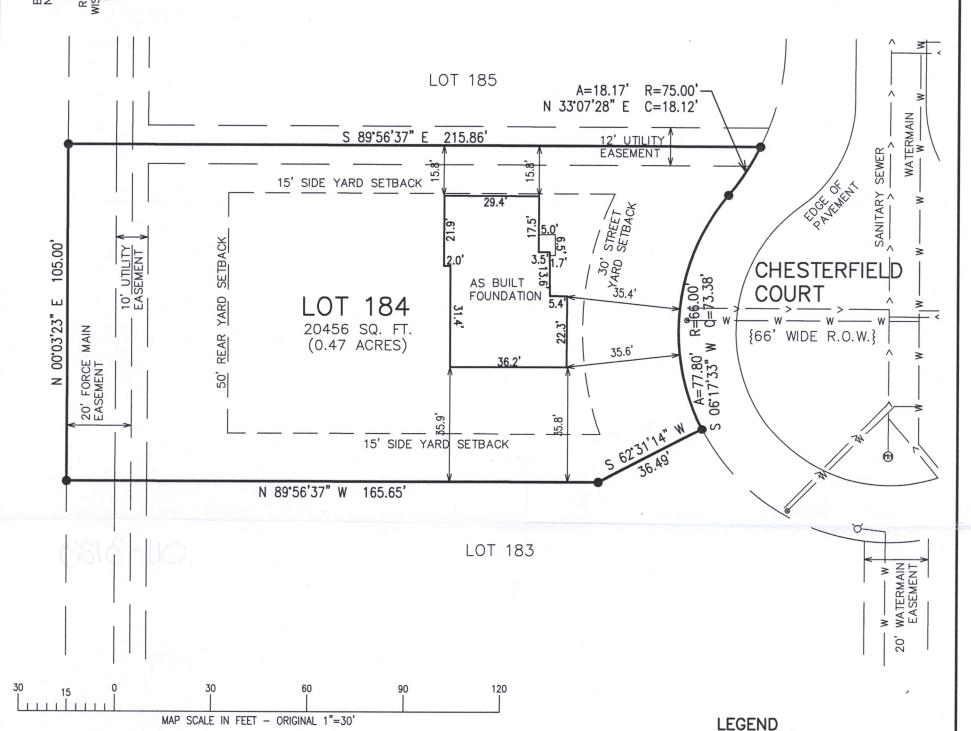

= FOUND IRON REBAR STAKE

⊕ = SANITARY SEWER MANHOLE

 \forall = HYDRANT

⊗ = WATER VALVE

 $\{XXX\}$ = RECORDED AS

T.F. = TOP OF FOUNDATION ELEVATION

NOTE: COPIES OF THIS MAP TO WHICH THE FOLLOWING CERTIFICATE WILL APPLY SHOW THE SURVEYOR'S ORIGINAL SEAL AND SIGNATURE IN RED INK. COPIES BY ANY OTHER MEANS MAY HAVE ALTERATIONS WHICH DO NOT REPRESENT THE SURVEYOR'S WORK PRODUCT.

I HEREBY CERTIFY THAT THE ABOVE DESCRIBED PROPERTY HAS BEEN SURVEYED UNDER MY DIRECTION AND THAT THE ABOVE MAP IS A TRUE REPRESENTATION THEREOF AND SHOWS THE SIZE AND LOCATION OF THE PROPERTY AND ITS EXTERIOR BOUNDARIES. THIS SURVEY IS MADE FOR THE USE OF THE PRESENT OWNERS OF THE PROPERTY, AND ALSO THOSE WHO PURCHASE, MORTGAGE, OR GUARANTEE THE TITLE THERETO WITHIN ONE YEAR FROM THE DATE HEREOF.

DATED: _____10/24/2018

REVISED 10/25/2021 TO SHOW SIZE AND LOCATION OF AS BUILT FOUNDATION

CHRISTOPHER A. HODGES P.L.S. 2760



PROJECT: 3249.184 DATE: 10/24/2018 SHEET 1 OF 1