
Parcel ID# WCP 00007

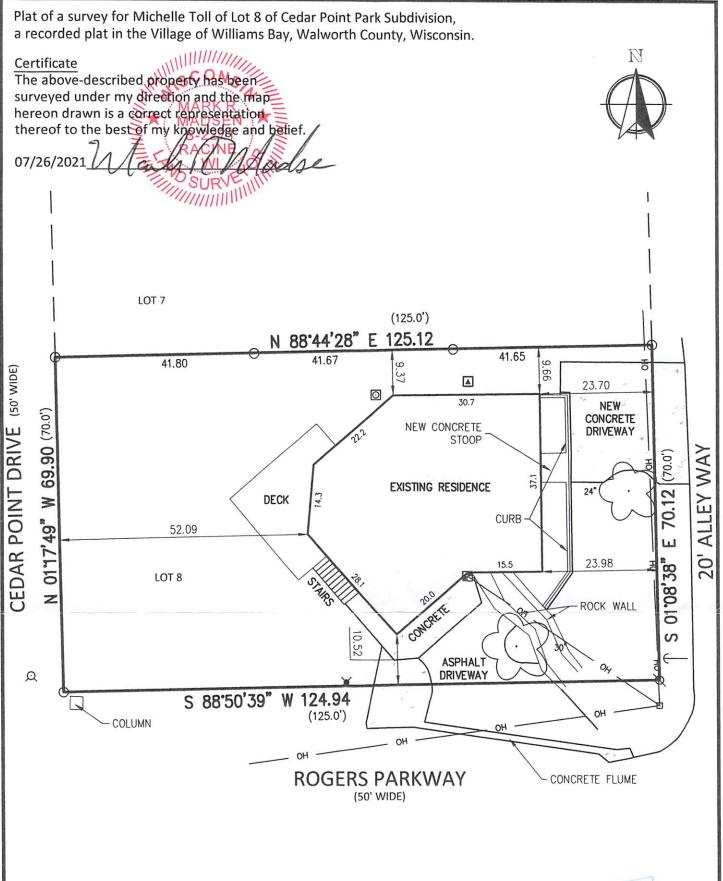

NOTES

BEARING BASE: GRID NORTH, WISCONSIN COORDINATE SYSTEM, SOUTH ZONE. BASED UPON NAD 1983 / 2011

LEGEND

∀ = FOUND IRON REBAR IN CONC MON.

O = FOUND 1-1/4" IRON PIPE

= HVAC

- POWER POLE

← = GUY WIRE

= ELECTRIC METER

-o+- = OVERHEAD WIRES

X = YARD LIGHT

Q = HYDRANT

O = GAS METER

JAN 2 4 2022 By SM

FIELD WORK 07-22-21 BY JWP/CRL DRAWN 07-26-21 BY DMB

SCALE 1" = 20'

SHEET 1 OF 1 SHEETS

JOB NO. 2018.0390.02



Nielsen Madsen + Barber

CIVIL ENGINEERS AND LAND SURVEYORS 1458 Horizon Blvd. Suite 200, Racine, WI. 53406 Tele: (262)634-5588 Website: www.nmbsc.net

011-3126