LOCATION: 22 Lackey Dr, Williams Bay, WI 53191

PREPARED FOR: Michael Baglio

## PROPERTY DESCRIPTION:

LYNCH & ASSOCIATES

5482 S. WESTRIDGE DRIVE NEW BERLIN, WI 53151 440 MILWAUKEE AVENUE BURLINGTON, WI 53105


(262) 402-5040

Lots 53 and 54 Lackey Brothers Subdivision being a part of the NE  $\frac{1}{4}$  of the SE  $\frac{1}{4}$  of Section 1, Township 1, Range 16 East, laocated in the Village of Williams Bay, Walworth County, Wisconsin.

CURRENT OWNER: Thomas & Colleen M Lamantia

TAX ID: WLB 00052(Lot 53) & WLB 00053(Lot 54)



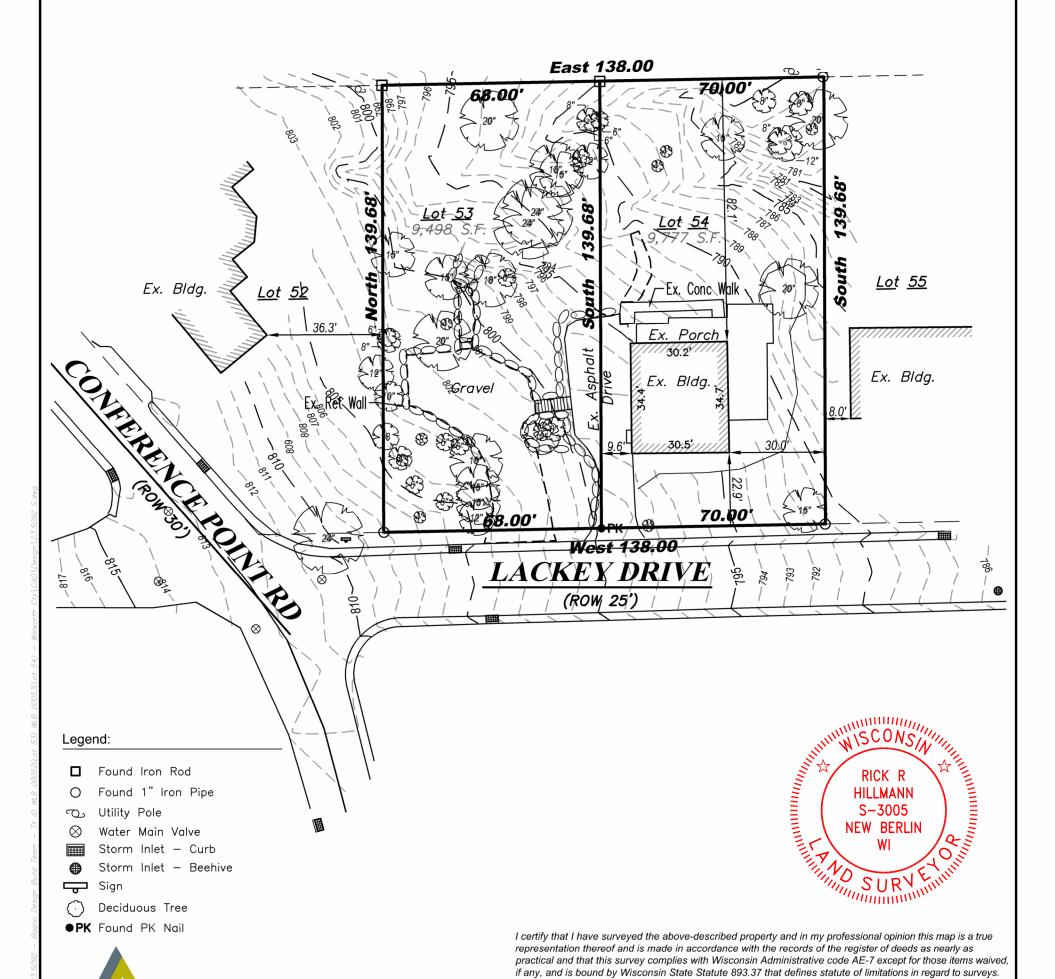

This survey was prepared for the exclusive use of the client and present owners of the property.

restrictions or other facts that could otherwise be disclosed in an ALTA/NSPS survey.

Rick R. Hillmann, Professional Land Surveyor, S-3005

plat of survey does not guarantee the existence, size and location of any easements, encumbrances,

No title policy has been provided to the surveyor regarding the property identified on this map. Therefore this

**DRAWING BY:** FIELD WORK BY: