

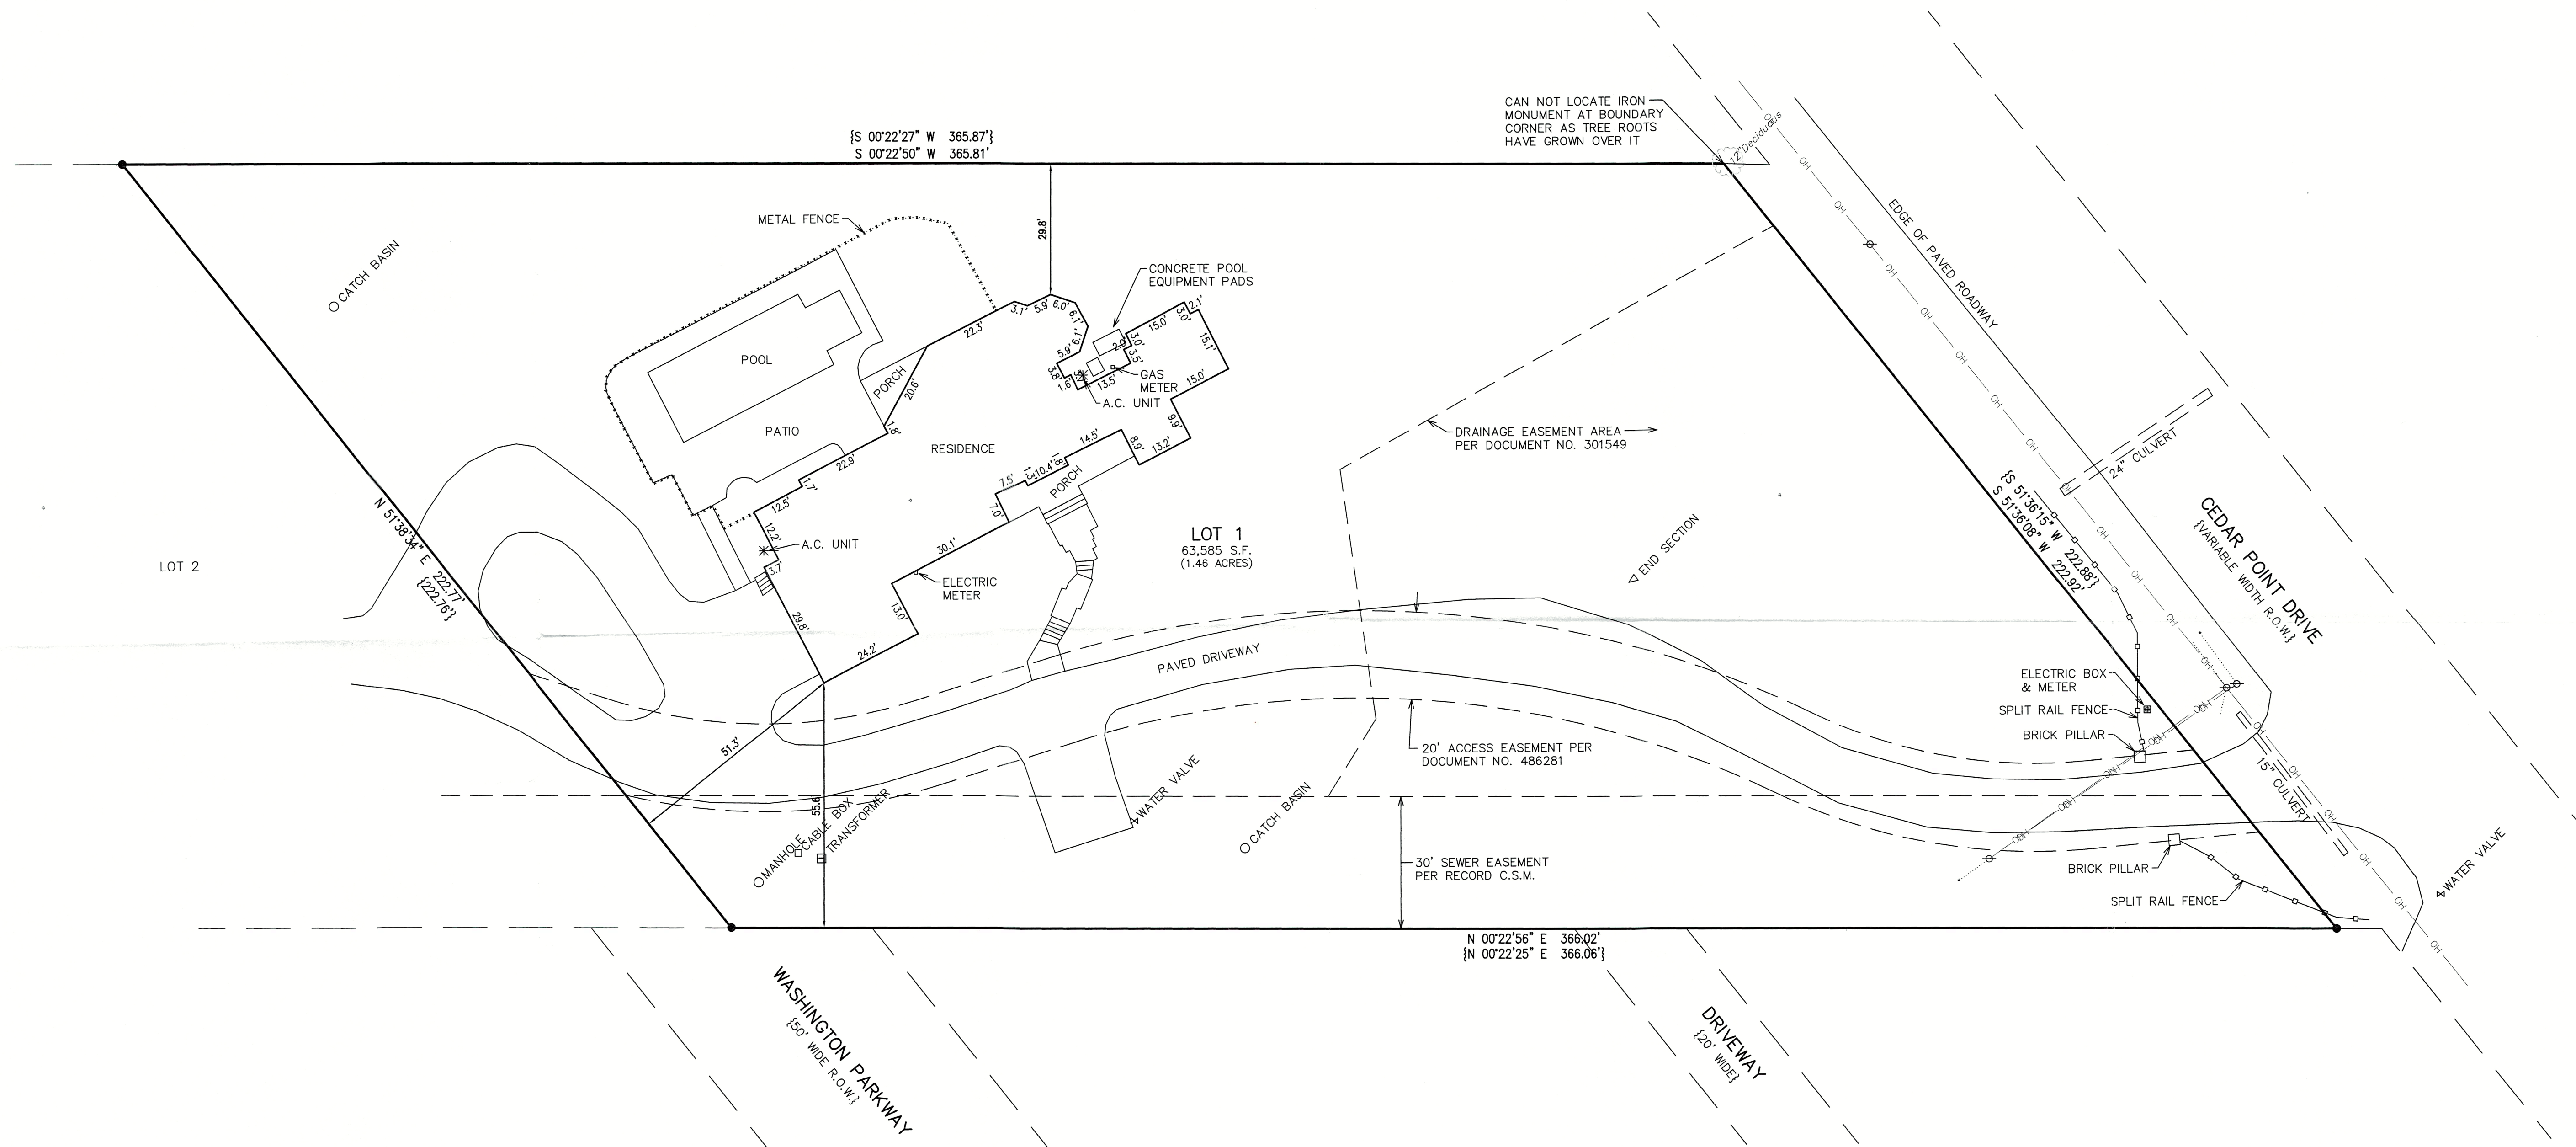


PLAT OF SURVEY  
LOT 1 OF CERTIFIED SURVEY MAP NO. 2263  
LOCATED IN PART OF THE NE 1/4 OF THE SE 1/4 OF SECTION 6, TOWN 1 NORTH, RANGE 17 EAST,  
VILLAGE OF WILLIAMS BAY, WALWORTH COUNTY, WISCONSIN

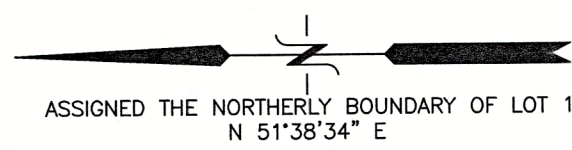

- LEGEND
- = FOUND IRON REBAR STAKE
  - = UTILITY POLE LOCATED
  - = GUY WIRE LOCATED
  - OH — = OVERHEAD WIRES
  - {XXX} = RECORDED AS

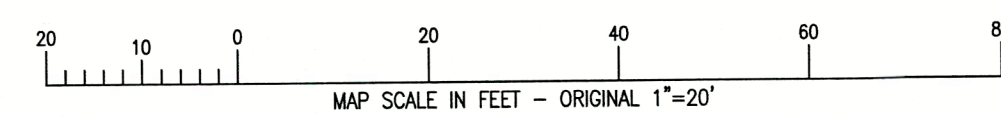


NOTE: COPIES OF THIS MAP TO WHICH THE FOLLOWING CERTIFICATE WILL APPLY SHOW THE SURVEYOR'S ORIGINAL SEAL AND SIGNATURE IN RED INK. COPIES BY ANY OTHER MEANS MAY HAVE ALTERATIONS WHICH DO NOT REPRESENT THE SURVEYOR'S WORK PRODUCT.

I HEREBY CERTIFY THAT THE ABOVE DESCRIBED PROPERTY HAS BEEN SURVEYED UNDER MY DIRECTION AND THAT THE ABOVE MAP IS A TRUE REPRESENTATION THEREOF AND SHOWS THE SIZE AND LOCATION OF THE PROPERTY AND ITS EXTERIOR BOUNDARIES. THIS SURVEY IS MADE FOR THE USE OF THE PRESENT OWNERS OF THE PROPERTY, AND ALSO THOSE WHO PURCHASE, MORTGAGE, OR GUARANTEE THE TITLE THERETO WITHIN ONE YEAR FROM THE DATE HEREOF.

DATED: 1/10/2024

*Christopher A. Hodges*  
CHRISTOPHER A. HODGES P.L.S. 2760

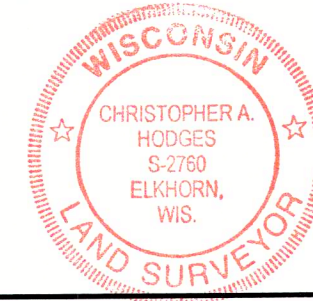

FARRIS, HANSEN & ASSOCIATES, INC.  
ENGINEERING — ARCHITECTURE — SURVEYING  
7 RIDGWAY COURT P.O. BOX 437  
ELKHORN, WISCONSIN 53121  
PHONE: (262) 723-2098 e-mail: office@farris-hansen.com

— WORK ORDERED BY —  
GARY & LAURIE MEISNER  
P.O. BOX 1344  
WILLIAMS BAY, WI 53191

PLAT OF SURVEY  
670 CEDAR POINT DRIVE  
WILLIAMS BAY, WISCONSIN

REVISIONS

PROJECT NO.  
3634.01.23  
DATE  
01/10/2024  
SHEET NO.  
1 OF 1

JAN 19 2024  
CHM

X:\PROJECTS\3634\01\_23\ACAD\3634\_01\_23.dwg

WA2263-1