

X:\PROJECTS\3249\INDIV\_LOTS\LOT\_148\ACAD\3249-148.DWG

# FARRIS, HANSEN & ASSOCIATES, INC.


ENGINEERING - ARCHITECTURE - SURVEYING  
7 RIDGWAY COURT - P.O. BOX 437 - ELKHORN, WISCONSIN 53121  
PHONE: (262) 723-2098 FAX: (262) 723-5886

## PLAT OF SURVEY - AS BUILT

LOT 148 OF BAILEY ESTATES, A SUBDIVISION  
LOCATED IN PART OF THE SE 1/4 OF THE NW 1/4  
OF SECTION 36, TOWN 2 NORTH, RANGE 16 EAST,  
VILLAGE OF WILLIAMS BAY, WALWORTH COUNTY, WISCONSIN

- WORK ORDERED BY -  
GERSTAD BUILDERS  
2703 BUSH TERRACE  
MC HENRY, IL 60051

LOT 147

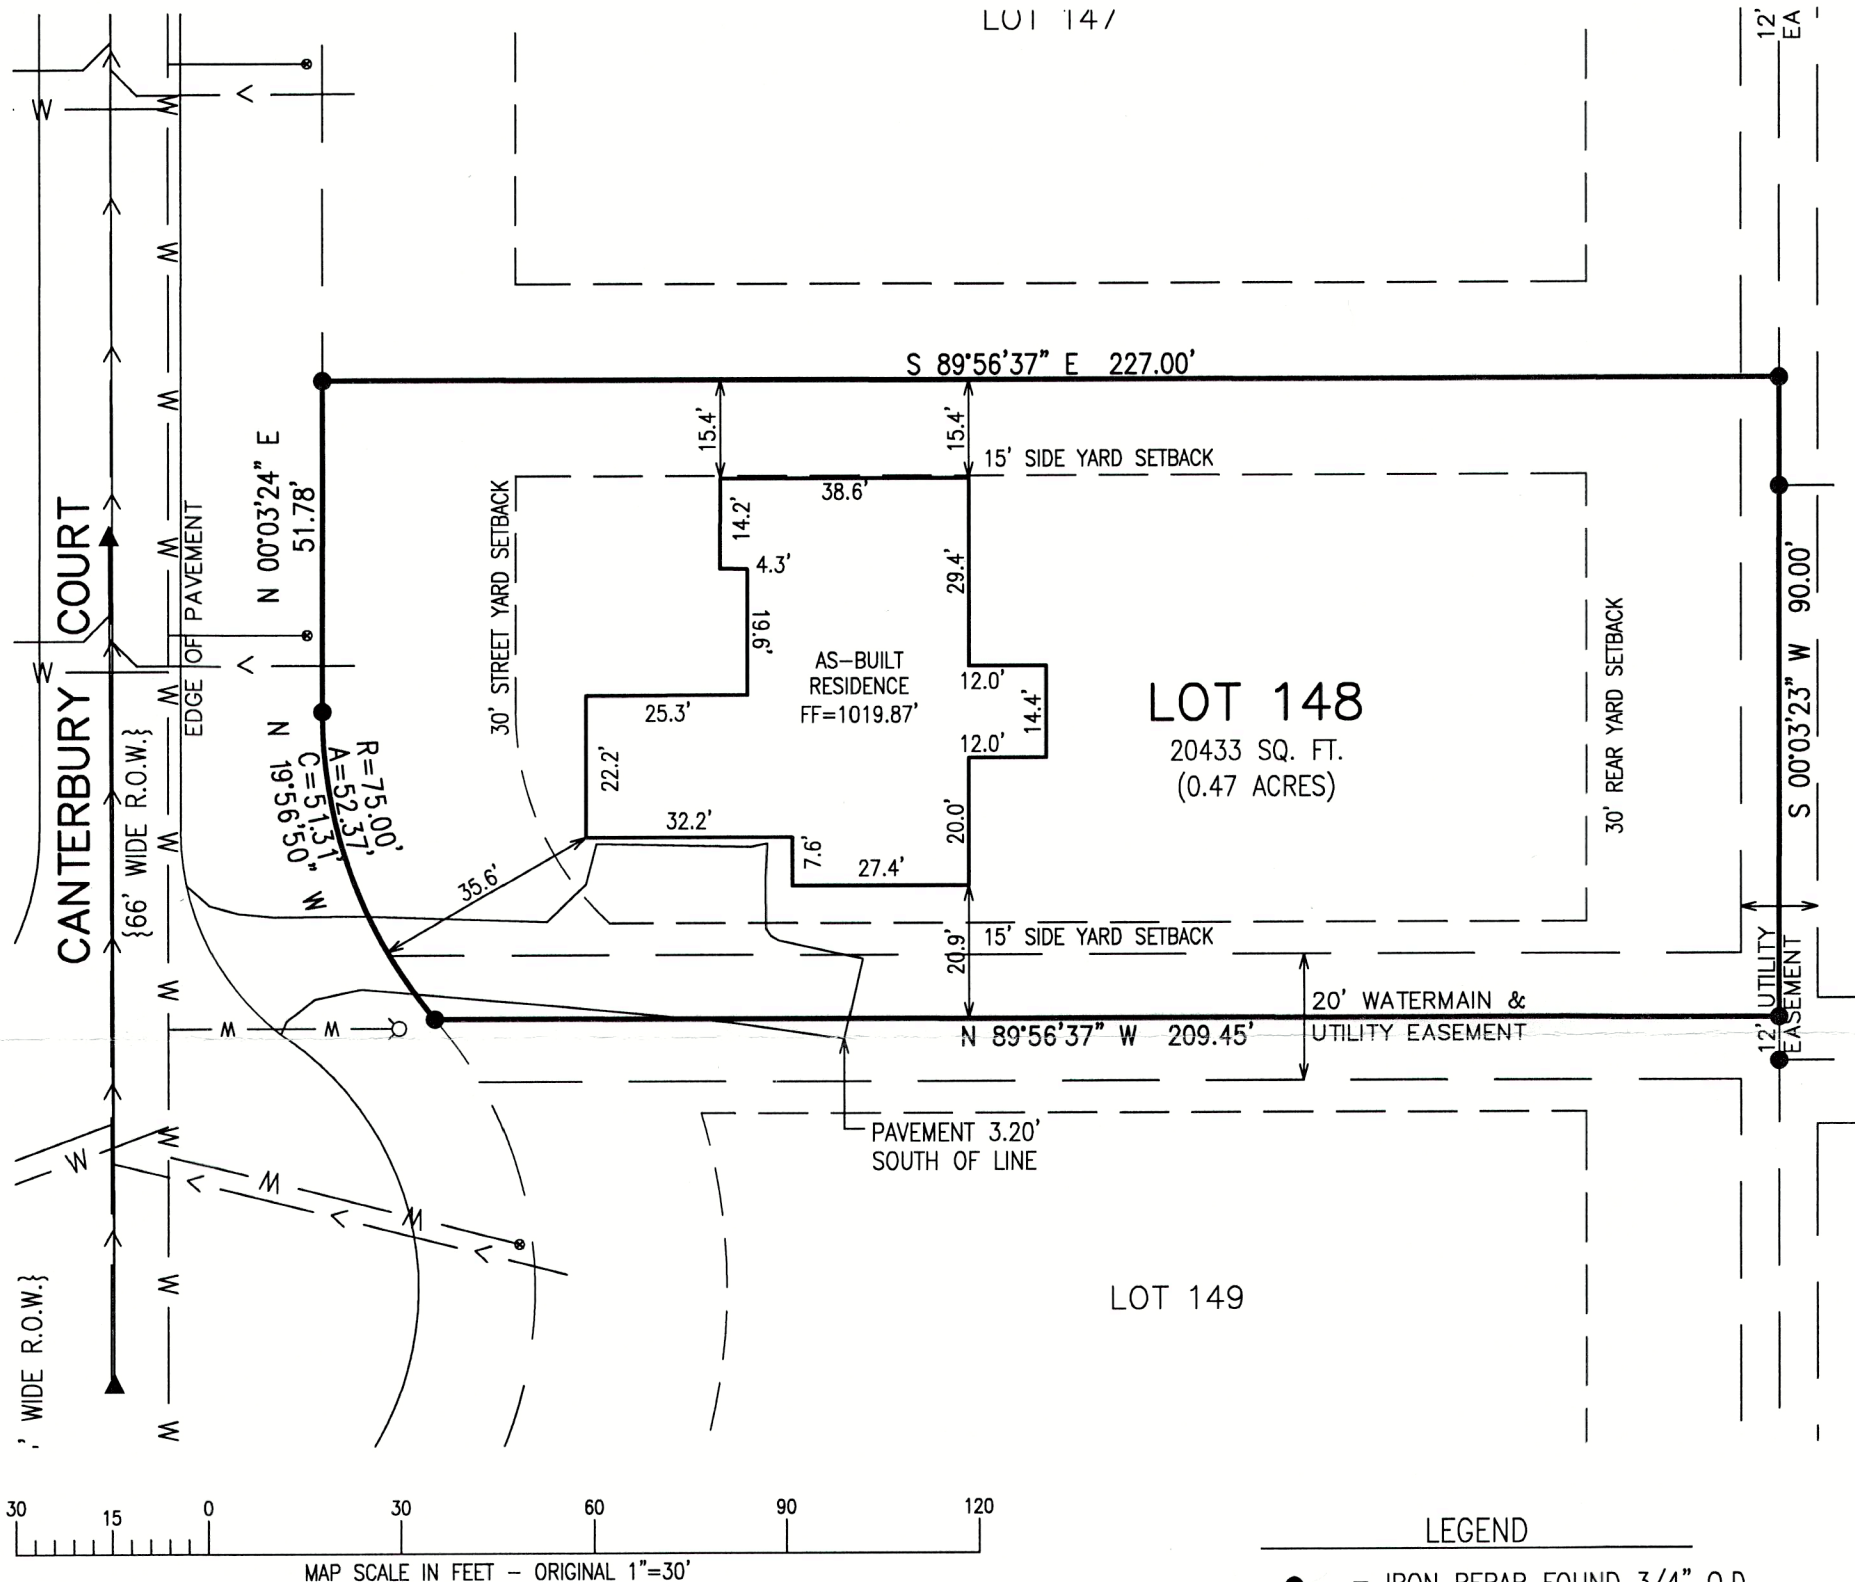


NOTE: COPIES OF THIS MAP TO WHICH THE FOLLOWING CERTIFICATE WILL APPLY SHOW THE SURVEYOR'S ORIGINAL SEAL AND SIGNATURE IN RED INK. COPIES BY ANY OTHER MEANS MAY HAVE ALTERATIONS WHICH DO NOT REPRESENT THE SURVEYOR'S WORK PRODUCT.

I HEREBY CERTIFY THAT THE ABOVE DESCRIBED PROPERTY HAS BEEN SURVEYED UNDER MY DIRECTION AND THAT THE ABOVE MAP IS A TRUE REPRESENTATION THEREOF AND SHOWS THE SIZE AND LOCATION OF THE PROPERTY AND ITS EXTERIOR BOUNDARIES. THIS SURVEY IS MADE FOR THE USE OF THE PRESENT OWNERS OF THE PROPERTY, AND ALSO THOSE WHO PURCHASE, MORTGAGE, OR GUARANTEE THE TITLE THERETO WITHIN ONE YEAR FROM THE DATE HEREOF.

DATED: 2/06/2024

CHRISTOPHER A. HODGES

P.L.S. 2760

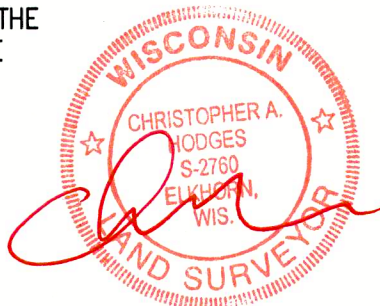

- LEGEND
- = IRON REBAR FOUND 3/4" O.D.
  - ▲ = SET NAIL/MAGNETIC NAIL
  - ⊕ = BENCHMARK
  - ⊗ = WATER HYDRANT
  - ⊗ = ELECTRICAL TRANSFORMER
  - Ⓜ = SANITARY MANHOLE
  - {xxx} = RECORDED AS
  - T.F. = TOP OF FOUNDATION ELEVATION
  - w — = WATERMAIN
  - > — = SANITARY SEWER w/FLOW DIRECTION
  - D — = STORM DRAINAGE

PROJECT: 3249.148  
DATE: 2/06/2024  
SHEET 1 OF 1

WBA1L-148

011-3257