
LOCATION: 154-3 WOOD STREET, WILLIAMS BAY, WISCONSIN 53191

PREPARED FOR: STEVE GREENBERG - CANYON DEVELOPMENT

PROPERTY DESCRIPTION: UNIT 3 IN BAYWOOD ESTATES CONDOMINIUM, BEING A CONDOMINIUM CREATED UNDER THE CONDOMINIUM OWNERSHIP ACT OF THE STATE OF WISCONSIN BY A "DECLARATION OF CONDOMINIUM FOR BAYWOOD ESTATES CONDOMINIUM", DATED THE 7TH DAY OF MARCH, 2001 AND RECORDED THE 25TH DAY OF JULY, 2001 IN THE OFFICE OF THE REGISTER OF DEEDS FOR WALWORTH COUNTY, WISCONSIN. THIS LAND BEING LOCATED IN PART OF THE SE 1/4 OF SECTION 1 AND PART OF THE NE 1/4 OF SECTION 12, TOWN 1 NORTH, RANGE 16 EAST, VILLAGE OF WILLIAMS BAY, WALWORTH COUNTY, WISCONSIN.


CURRENT OWNER: CHRISTOPHER FABER TRUST & SHEILA FABER TRUST

TAX ID: WBE 00003

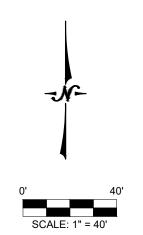

Legend:

- Found Iron Rod
- O Found 1" Iron Pipe
- Fire Hydrant
- Storm Inlet
- End Section

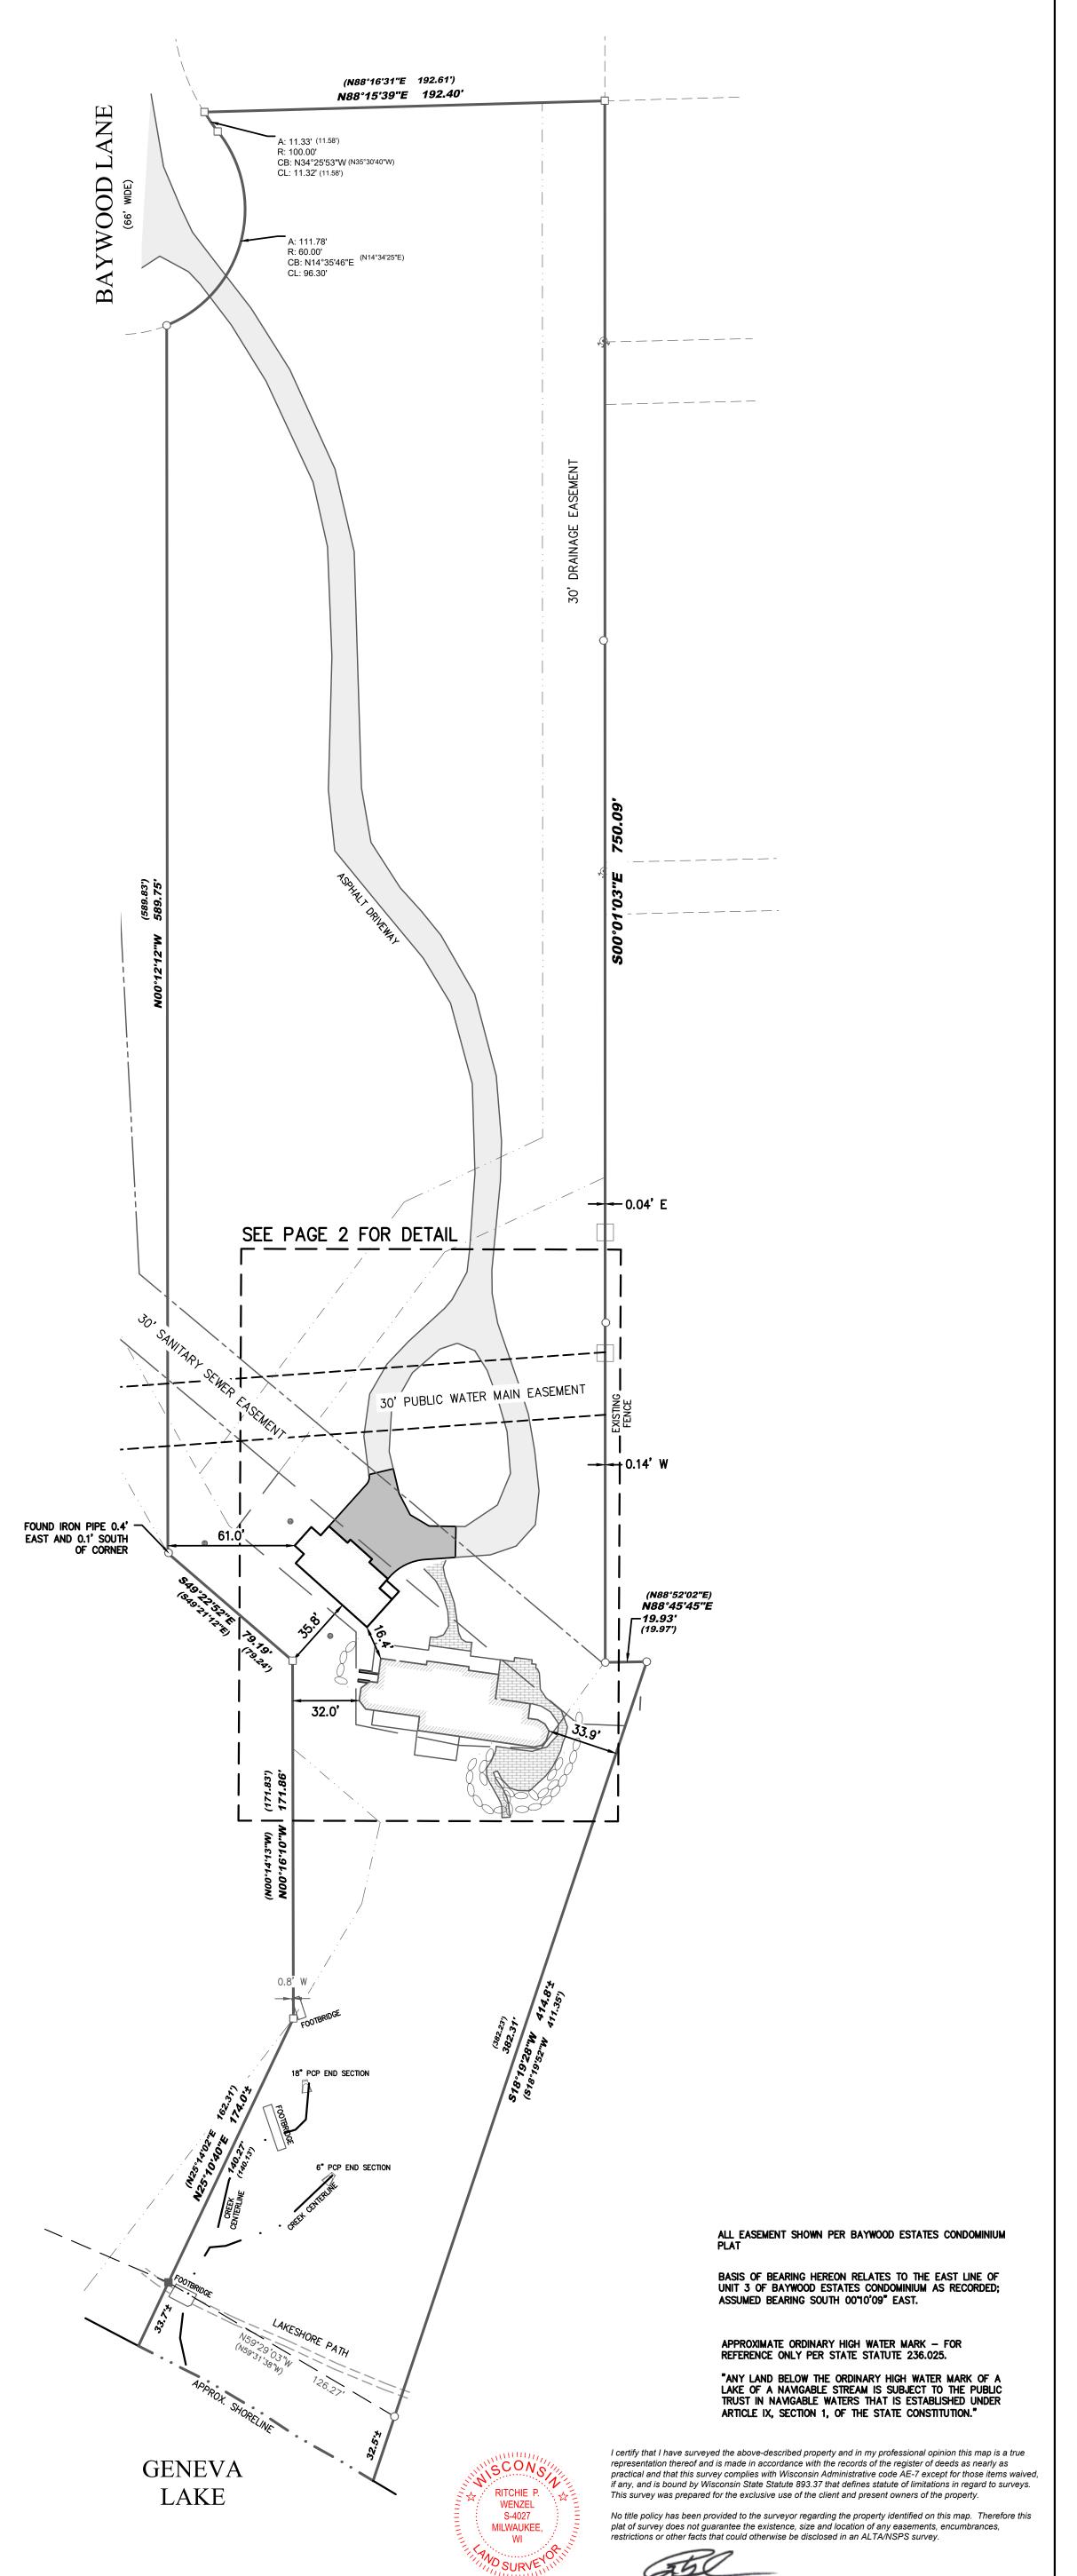

Ritchie P. Wenzel, Professional Land Surveyor, S-4027



