


HAROLD H. KOLB

REGISTERED PROFESSIONAL LAND SURVEYOR
LAKE GENEVA, WISCONSIN

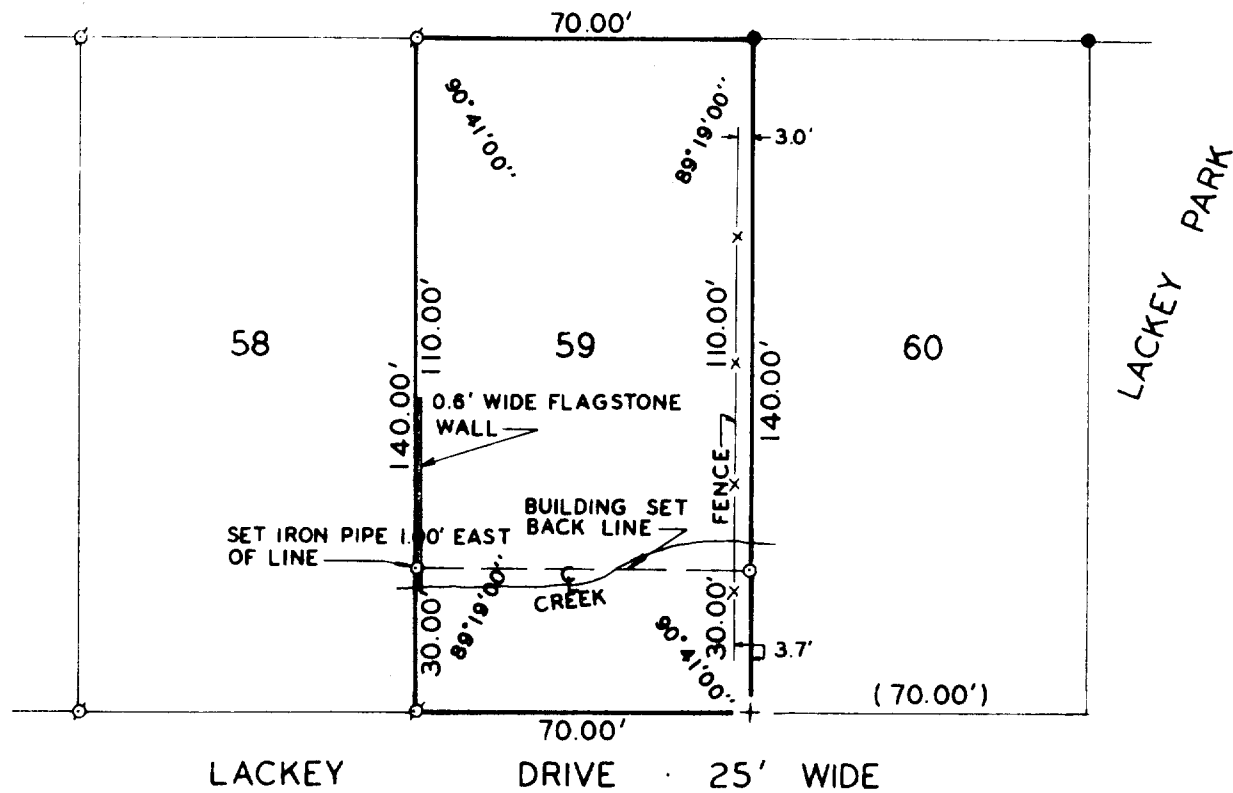


PLAT OF SURVEY OF

LOT 59, LACKEY BROTHERS SUBDIVISION,
VILLAGE OF WILLIAMS BAY, WALWORTH
COUNTY, WISCONSIN.

ORDERED BY: MRS. JAMES BLAND

ACCURACY: DISTANCES $\pm 0.01'$
ANGLES $\pm 05''$

ERROR OF CLOSURE--LESS THAN
ONE PART IN 3000

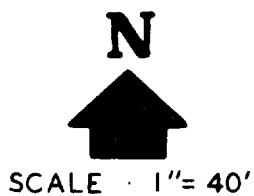

LEGEND

- O - IRON PIPE PLACED, 1" x 24" 1.13 LB./LIN. FT.
- - CONCRETE MONUMENT, 5" DIA. x 30"
- + - CUT CROSS
- - IRON PIPE FOUND
- () - AS PLATTED

HAROLD H. KOLB
WISCONSIN REGISTERED LAND SURVEYOR, S-187
DATE Feb 19, 1977

11-338