


SURVEYING & SUBDIVIDING
DELAN, WISCONSIN 53115

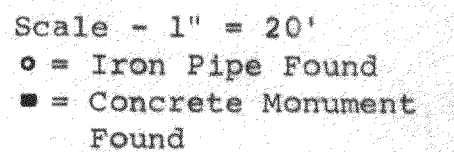

I, George T. Dunham, Surveyor, certify that I have surveyed the property described as follows,
Lot 41 of Lackey Brothers Subdivision located in the Village of Williams Bay, Walworth County, Wisconsin,
and the above map is a true representation thereof and shows the size and location of the property, its exterior boundaries, the location and dimensions of all structures thereon, fences, apparent easements and roadways and visible encroachments, if any.
This survey is made for the exclusive use of the present owners of the property, and also those who purchase, mortgage, or guarantee the title thereto within one (1) year from date hereof; and as to them I warrant the accuracy of said survey and map.
February 26, 1977

A circular seal with a dotted border. The word "WISCONSIN" is arched across the top. The name "GEORGE T. DUNHAM" is in the center. Below it is "DELAVAN, WIS.". The words "LAND SURVEYOR" are arched across the bottom. Two five-pointed stars are positioned on the left and right sides, separating the top and bottom text.