


HAROLD H. KOLB

REGISTERED PROFESSIONAL LAND SURVEYOR
LAKE GENEVA, WISCONSIN

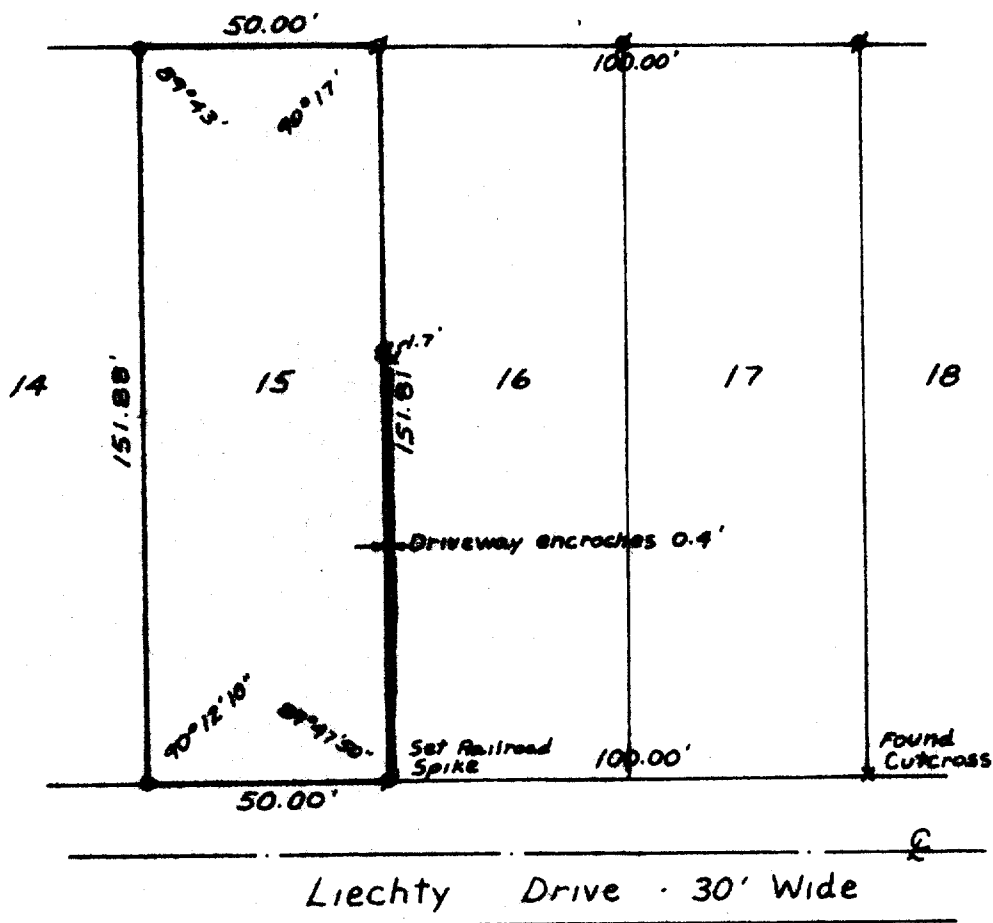

PLAT OF SURVEY OF

LOT 15, SUMMER HAVEN, VILLAGE
OF WILLIAMS BAY, WALWORTH COUNTY,
WISCONSIN.

OWNER: DONALD BARRECA

ORDERED BY: BAY REALTY
WILLIAMS BAY, WI



Parcel W SU - 18

I, HAROLD H. KOLB, DO HEREBY CERTIFY THAT I HAVE
SURVEYED THE PROPERTY HEREON DESCRIBED ACCORDING
TO THE OFFICIAL RECORDS, AND THAT THE PLAT HEREON
IS A CORRECT REPRESENTATION OF THE LOT LINES.



Scale: 1" = 40'

LEGEND

- O - IRON PIPE PLACED
- β - IRON PIPE FOUND

Harold H. Kolb

HAROLD H. KOLB
WISCONSIN REGISTERED LAND SURVEYOR, S-187
DATE *July 12, 1977*

11-360