
HAROLD H. KOLB

REGISTERED PROFESSIONAL LAND SURVEYOR LAKE GENEVA, WISCONSIN

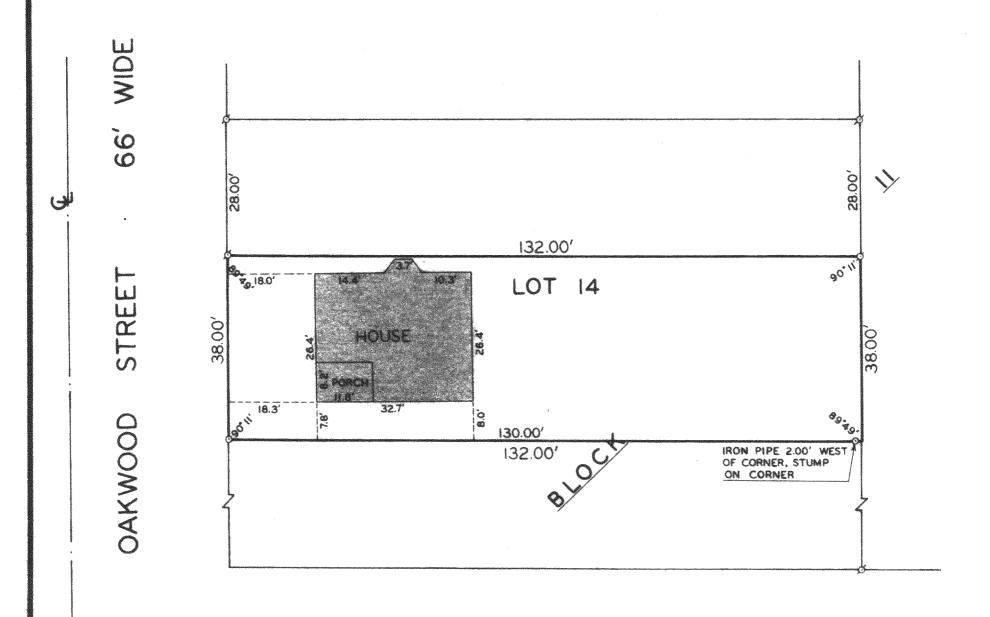

CENTER STREET · 66' WIDE

PLAT OF SURVEY OF

LOT 14, EXCEPT THE NORTH 28 FEET THEREOF IN BLOCK 11. WILLIAMS 2ND ADDITION, VILLAGE OF WILLIAMS BAY, WALWORTH COUNTY, WISCONSIN.

ORDERED BY: HOTTON REALTY



SCALE : 1"=20"

LEGEND

- φ IRON PIPE FOUND
- O IRON PIPE PLACED
- - CONCRETE MONUMENT

X - SPIKE



I. HAROLD H. KOLB, DO HEREBY CERTIFY THAT I HAVE SURVEYED THE PROPERTY HEREON DESCRIBED ACCORDING TO THE OFFICIAL RECORDS, AND THAT THE PLAT HEREON IS A CORRECT REPRESENTATION OF THE LOT LINES.

HAROLD H. KOLB WISCONSIN REGISTERED LAND SURVEYOR, S-187

DATE <u>JUNE 17, 1977</u>