


Plat of survey of a parcel of land located in the Northwest 1/4 of Section 1, T1N, R16E, Village of Williams Bay, Walworth County Wisconsin.

° INDICATES IRON NAIL FOUND

East line of lot 4  
of Certified Survey  
Map No. 170  
Bear North  
platted

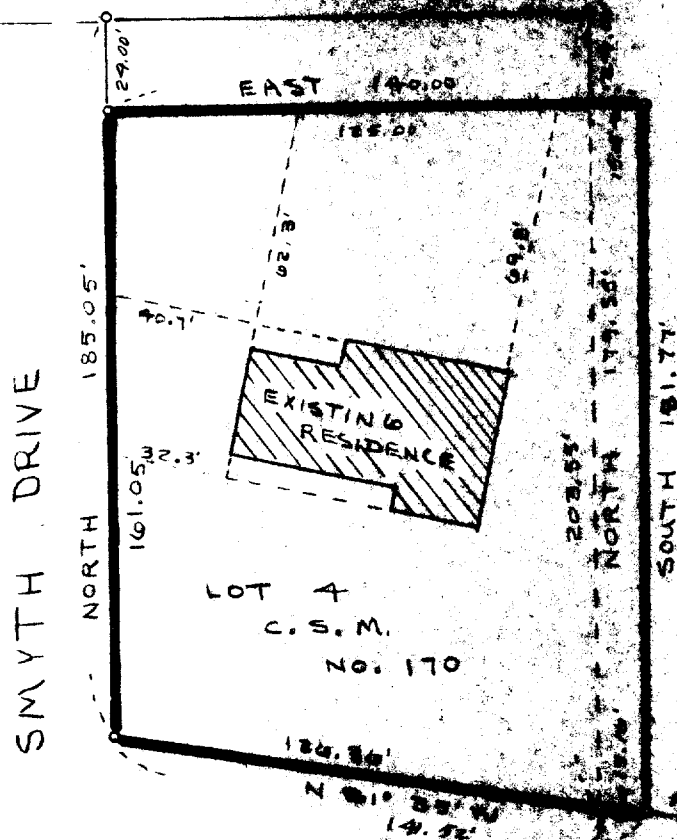

SCALE 1"=50'

50 25 0 50

Surveyed for:  
Ted T. Kocal  
Williams Bay Wisconsin


I hereby certify that the property hereon described has been surveyed under my direction and that this plat of survey is a true and accurate representation of the property to the best of my knowledge and belief.

*Robert A. Farris*

Robert A Farris  
Surveyor S-1293

Dated: 13 May 1978

Southeast corner  
of Lot 4 C. S. M. 170  
CENTER ST.

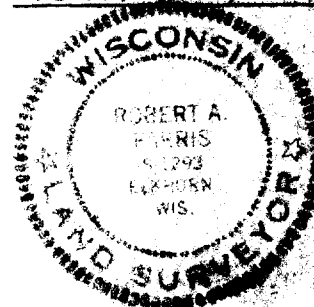

Description:

A parcel of land located in the Northwest 1/4 of Section 1, T1N, R16E, Village of Williams Bay, Walworth County Wisconsin; described as follows: Lot 4 of Certified Survey Map No. 170 except the North 20 feet thereof. Also a parcel of land described as follows: Beginning at the Southeast corner of Lot 4 of said Certified Survey Map No. 170: thence North 179.33 feet: thence East 15.00 feet: thence South 181.77 feet to the North line of Center Street in the Village of Williams Bay: thence N81° 35' W along said Street line 15.16 feet to the place of beginning.

FARRIS, HANSEN & COOPER, INC.  
715 W. Walworth St. P.O. Box 467  
Elkhorn, WI 53121

WA 170-4

Drawing No. 1334 9-369