
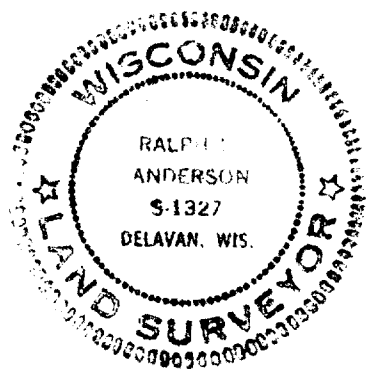


PLAT OF SURVEY

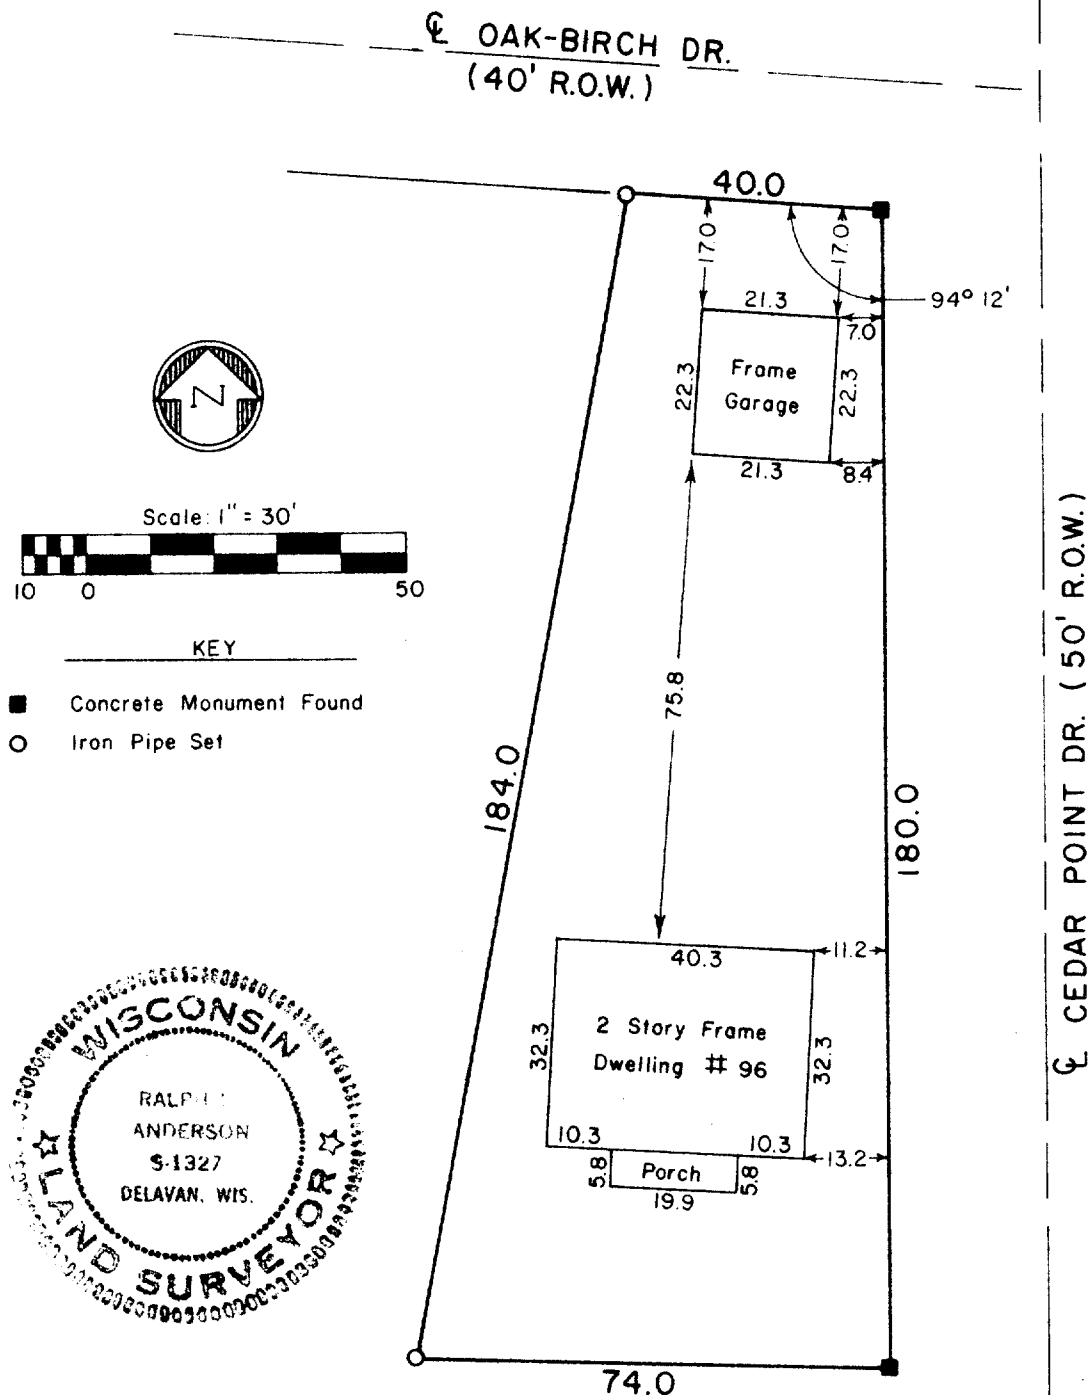

DESCRIPTION:

Lot 18 in Cedar Point Park, first addition to the Village of Williams Bay, Section 6, Town 1 North, Range 17 East, Walworth County, Wisconsin.

SURVEYOR'S CERTIFICATE

I have surveyed the above described property and the above map is a true representation thereof and shows the size and location of the property, its exterior boundaries, the location and dimensions of all visible encroachments. This survey is made for the exclusive use of the present owners of the property, and also those who purchase, mortgage, or guarantee the title thereto within one (1) year from date hereof and as to them I warrant the accuracy of said survey and map.

Date 2 June 1978

Ralph W. Anderson
Ralph W. Anderson, RLS 1327

Prepared By	Prepared For	Date	Sheet Number
VALENTINE AND ASSOCIATES, INC.	JAMES J. AHERN	6-2-78	1 of 1
DELAVER, WISCONSIN	CHICAGO, ILLINOIS	Job Number	Reference
		7858	File