
DUNHAM SURVEYING, S.C.

SURVEYING & SUBDIVIDING DELAVAN, WISCONSIN 53115

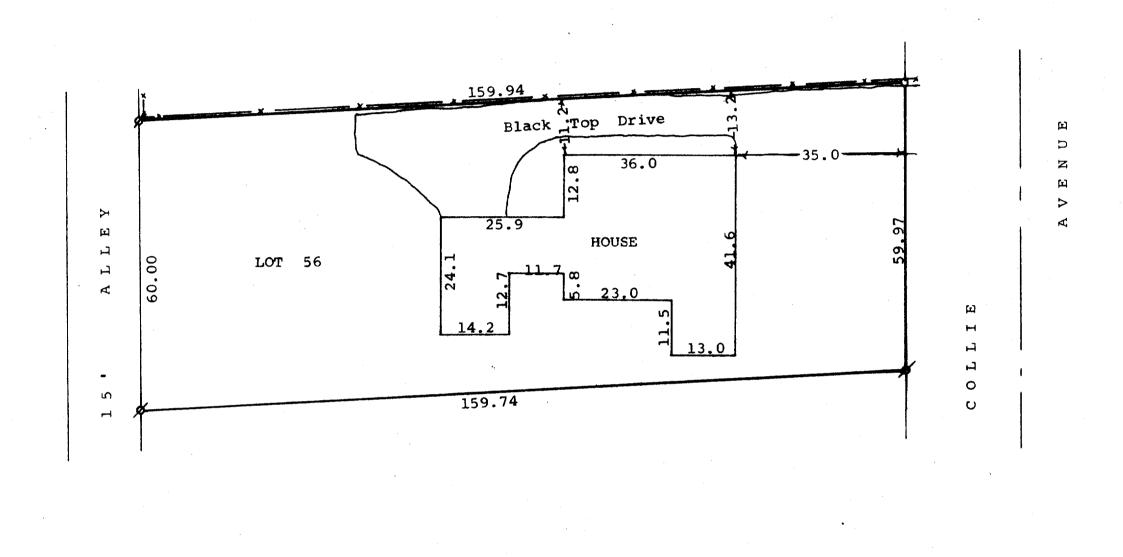

Scale - 1" = 20' ✓ = Iron Pipe Found o = Iron Pipe Set -x-x-= Fence line


STATE OF WISCONSIN) SS

I, James M. Dunham, Surveyor, certify that I have surveyed the property described as follows,

Lot 56 of Bay View Subdivision, located in the Village of Williams Bay, Walworth County, Wisconsin,

and the above map is a true representation thereof and shows the size and location of the property, its exterior boundaries, the location and dimensions of all structures thereon, fences, apparent easements and roadways and visible encroachments, if any. This survey is made for the exclusive use of the present owners of the property, and also those who purchase, mortgage, or guarantee the title thereto within one (1) year from date hereof; and as to them I warrant the accuracy of said survey and map. July 14, 1978

James M. Dunham, Surveyor

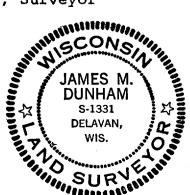

K & E 10-9155 250-9 76