


**SURVEYING & SUBDIVIDING
DELAN, WISCONSIN 53115**



STATE OF WISCONSIN)
COUNTY OF WALWORTH) SS

I, James M. Dunham, Surveyor, certify that I have surveyed the property described as follows,
Lot 24 of Summer Haven, located in the Southeast $\frac{1}{4}$ of Section 1,
T1N, R16E, Village of Williams Bay, Walworth County, Wisconsin,
and that the above map is a true representation thereof and shows the size and location of the property, its exterior boundaries, the location of all visible structures and dimensions of all principal buildings thereon, boundary fences, apparent easements, roadways and visible encroachments, if any. This survey is made for the use of the present owners of the property, and also those who purchase, mortgage, or guarantee the title thereto within one (1) year from date hereof.
July 7, 1981.

James M. Dunham, Surveyor

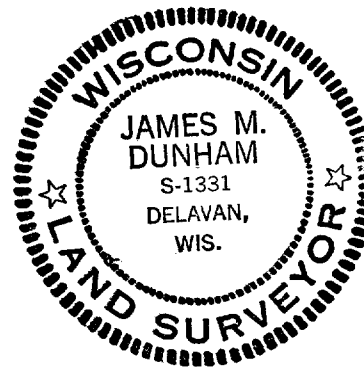

Scale - 1" = 10'

○ = Iron Pipe Found

● = Iron Rod Found

⊗ = Iron Pipe Found 18" Underground
and Iron Rod Set