


N

GEORGE T. DUNHAM
SURVEYING & SUBDIVIDING
DELAVAN, WISCONSIN

Scale - 1" = 20'
● = Conc. Monument
○ = Iron Pipe

ROAD

DARTMOUTH

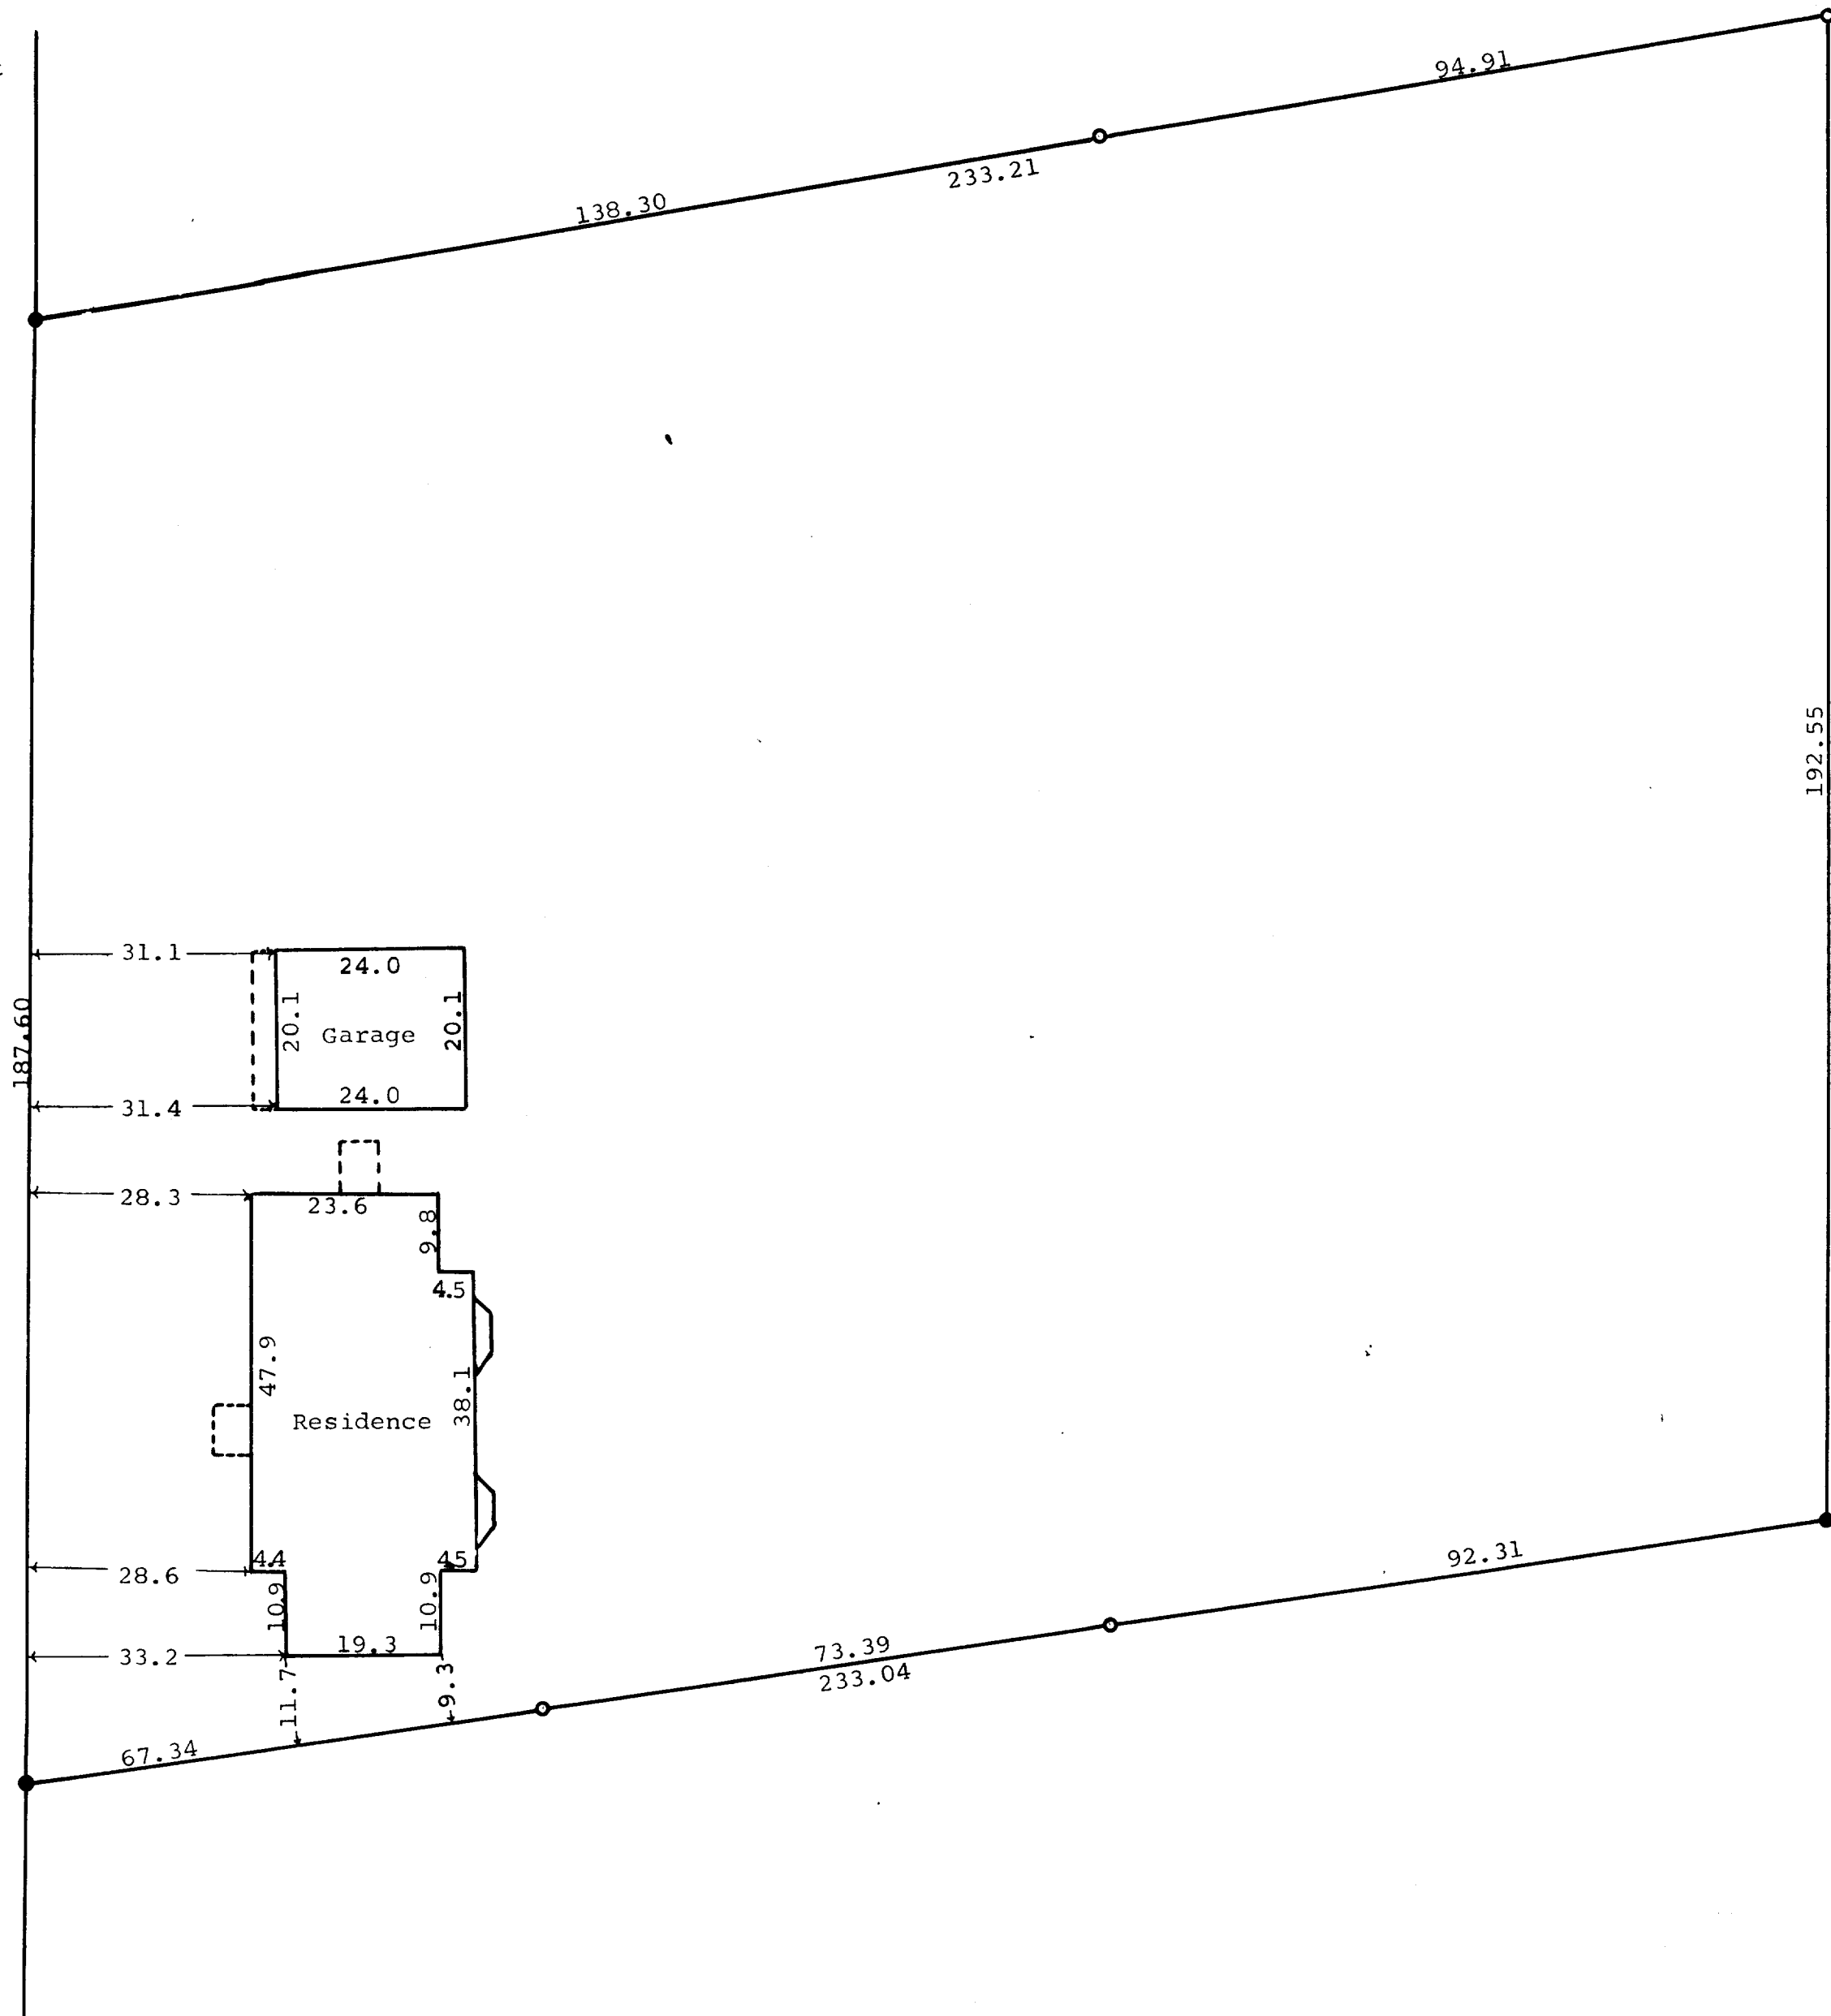

STATE OF WISCONSIN)
WALWORTH COUNTY) SS

I, George T. Dunham, do hereby certify that I have surveyed the property described as follows:
Lot 4, Block 2 of University Heights located in the Village of Williams Bay, Walworth County, Wisconsin.
and that the plat shown above is a correct representation of the property lines and location of buildings on said property and the correct measurements thereof.
July 14, 1964

George T. Dunham
George T. Dunham, Surveyor