


DUNHAM SURVEYING, S.C.
SURVEYING & SUBDIVIDING
DELAVAL, WISCONSIN 53115

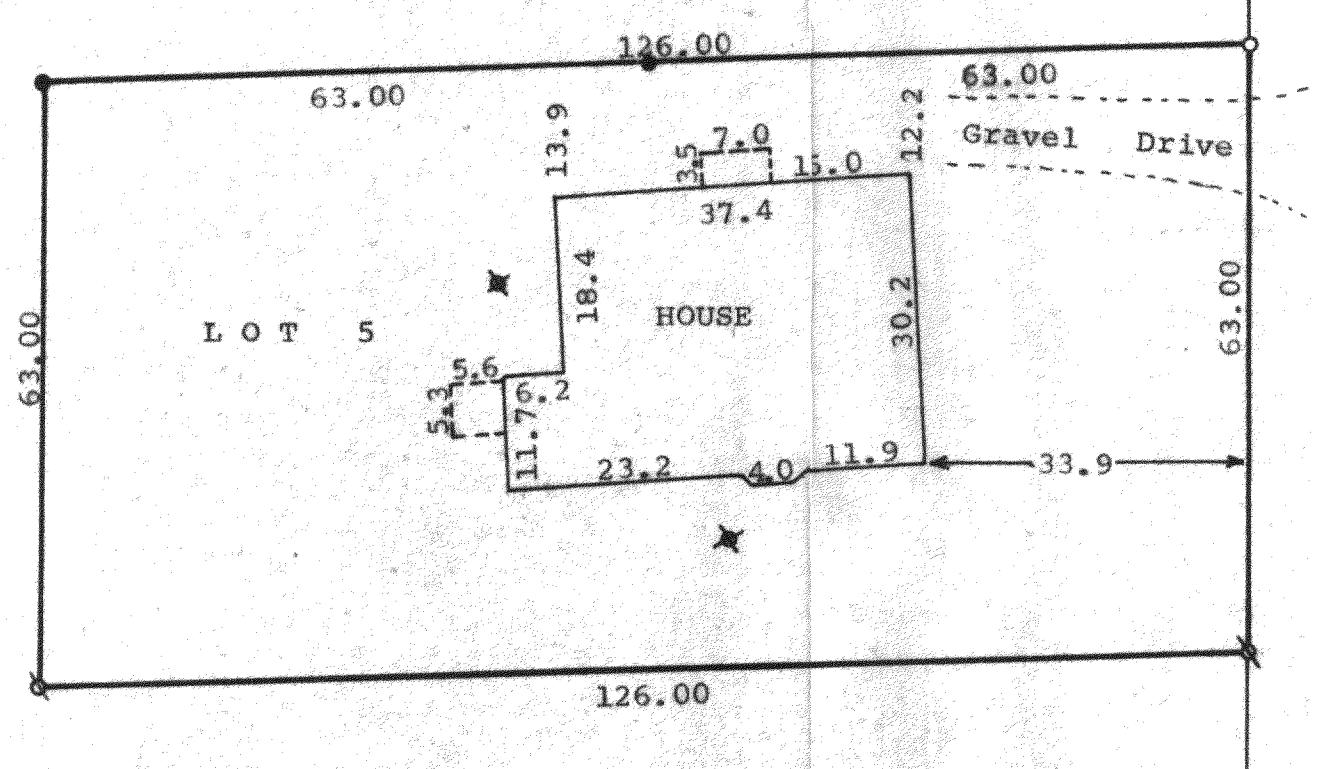

Scale - 1" = 20'
 • = Concrete Monument
 ♦ = Iron Pipe Found
 ○ = Iron Pipe Set
 ✕ = Concrete Cover

STATE OF WISCONSIN
COUNTY OF WALWORTH) SS

I, James M. Dunham, Surveyor, certify that I have surveyed the property described as follows,

Lot 5 of Madison's Addition to the Village of Williams Bay, Walworth County, Wisconsin,

and that the above map is a true representation thereof and shows the size and location of the property, its exterior boundaries, the location of all visible structures and dimensions of all principal buildings thereon, boundary fences, apparent easements, roadways and visible encroachments, if any. This survey is made for the use of the present owners of the property, and also those who purchase, mortgage, or guarantee the title thereto within one (1) year from date hereof.

December 14, 1979

James M. Dunham
James M. Dunham, Surveyor

