


KOLB LAND CONSULTING, INC.  
 LAND SURVEYING · SUBDIVIDING · LAND PLANNING

LAKE GENEVA, WISCONSIN 53147

WHITEWATER, WISCONSIN 53190

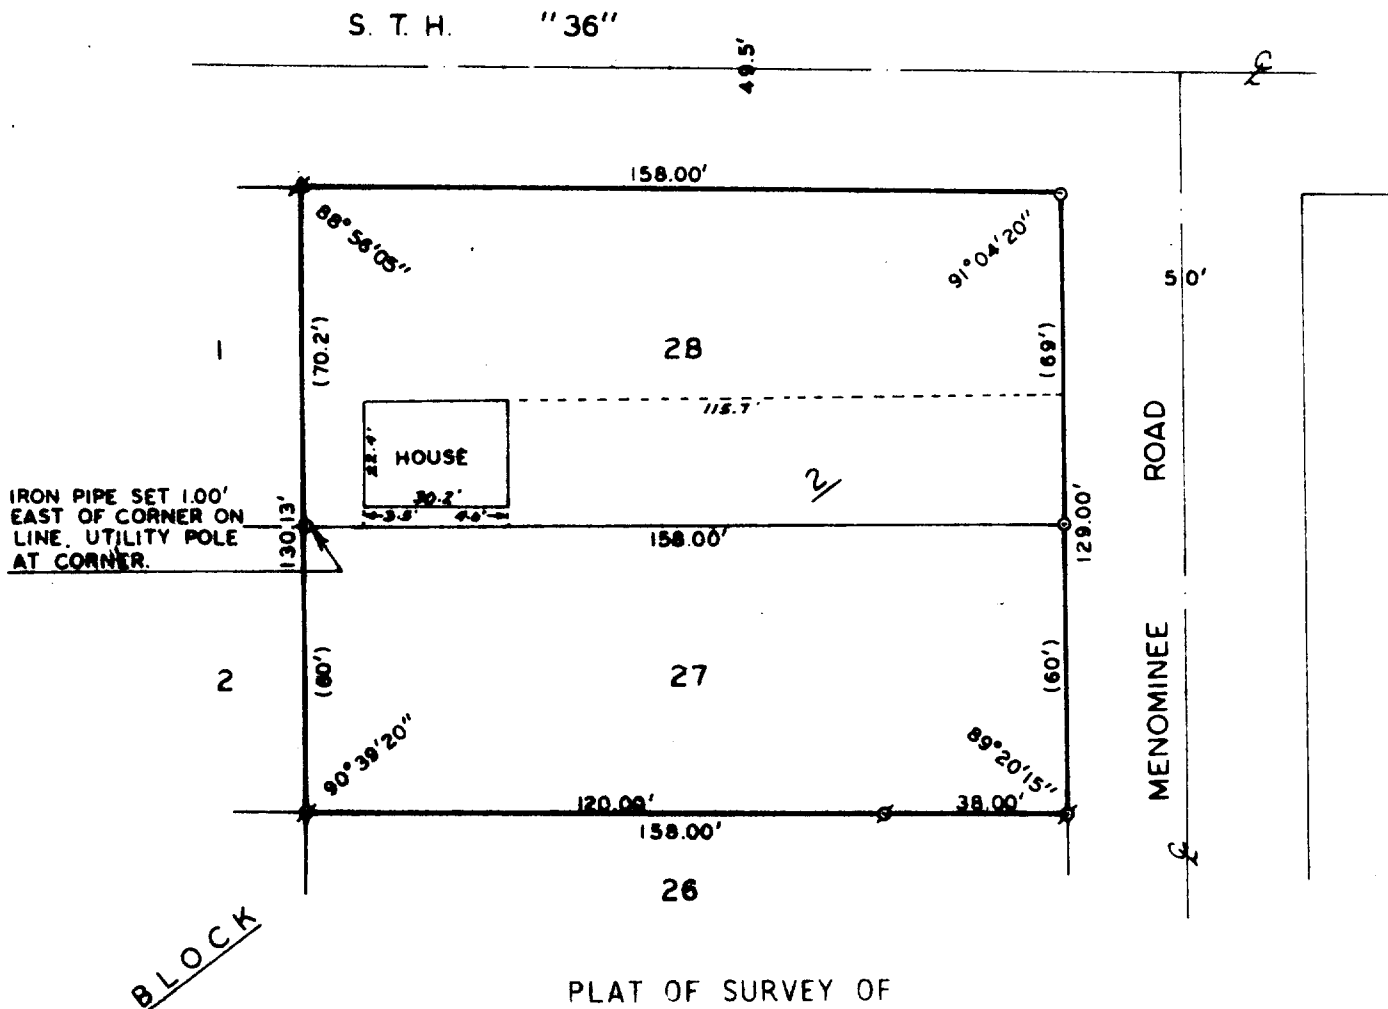

PLAT OF SURVEY OF

LOTS 27 AND 28, BLOCK 2, HARBOR VIEW  
 SUBDIVISION, VILLAGE OF WILLIAMS BAY,  
 WALWORTH COUNTY, WISCONSIN.

ORDERED BY: CALDWELL BANKER - GENEVA LAKES AREA REALTOR  
 838 MAIN STREET  
 LAKE GENEVA, WI 53147

OWNER: FRANK BURES AND OTHERS



SCALE - 1"=40'

- LEGEND
- σ - IRON PIPE FOUND
  - ⋈ - IRON ROD FOUND
  - - IRON PIPE SET
  - ( ) - RECORDED AS

HAROLD H. KOLB, DO HEREBY CERTIFY  
 THAT I HAVE SURVEYED THE PROPERTY  
 HEREON DESCRIBED ACCORDING TO THE  
 OFFICIAL RECORDS, AND THAT THE PLAT  
 HEREON IS A CORRECT REPRESENTATION  
 OF THE LOT LINES TO THE BEST OF MY  
 KNOWLEDGE AND BELIEF.

*Harold H. Kolb*  
 HAROLD H. KOLB  
 WISCONSIN REGISTERED LAND SURVEYOR, S- 187  
 DATE Aug. 8, 1983

WHV 00034

11-432-K