


PLAT OF SURVEY OF LOT 48 OF CEDAR POINT PARK 1ST ADDITION  
VILLAGE OF WILLIAMS BAY, WALWORTH COUNTY, WISCONSIN  
FOR CRAIG CURRY

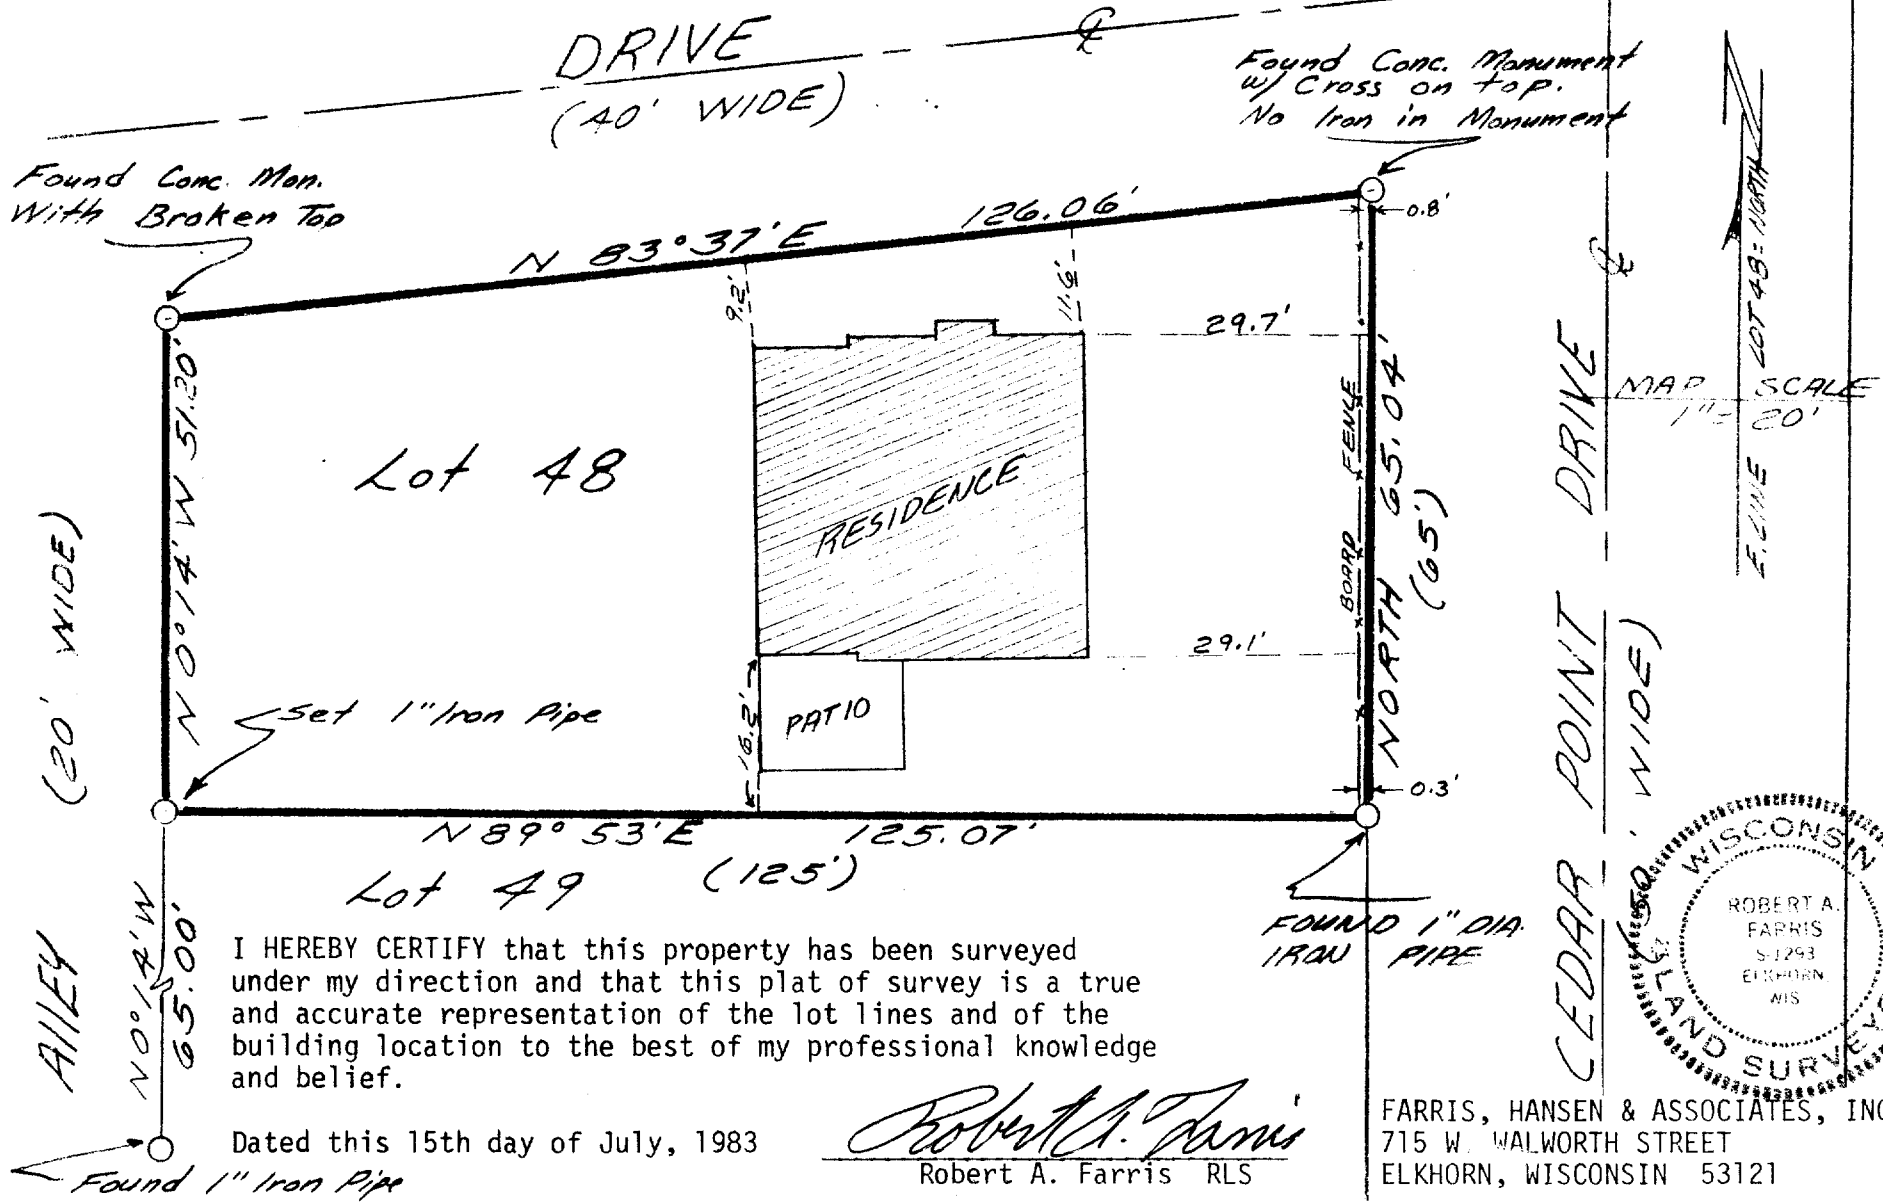

DRAWING NUMBER 2131

11-433-F