


# HAROLD H. KOLB

REGISTERED PROFESSIONAL LAND SURVEYOR  
LAKE GENEVA, WISCONSIN

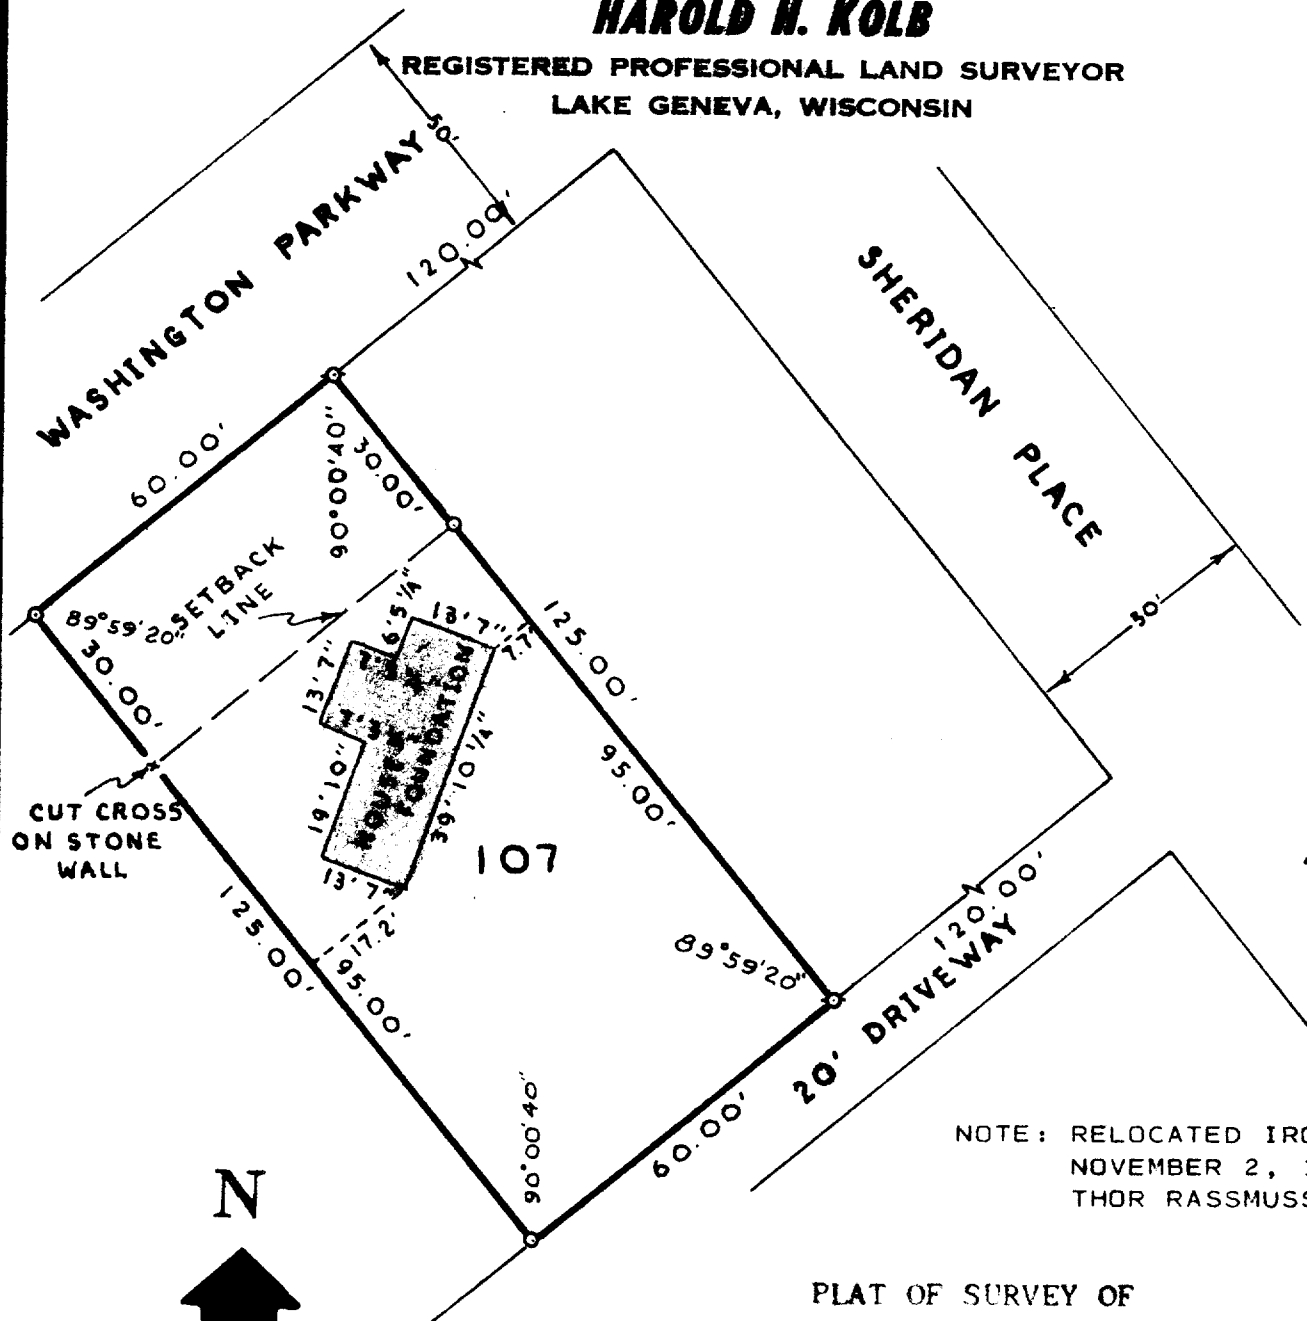

NOTE: RELOCATED IRON PIPES  
NOVEMBER 2, 1984 FOR  
THOR RASMUSSEN


N



SCALE: 1" = 30'

## LEGEND

- φ - IRON PIPE FOUND
- - IRON PIPE PLACED
- - CONCRETE MONUMENT
- - BUILDING CORNER STAKE

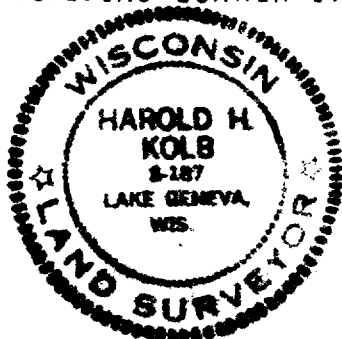

## PLAT OF SURVEY OF

Lot 107, Original Cedar Point  
Park, Village of Williams Bay,  
Walworth County, Wisconsin.

I, HAROLD H. KOLB, DO HEREBY CERTIFY THAT I HAVE  
SURVEYED THE PROPERTY HEREON DESCRIBED ACCORDING  
TO THE OFFICIAL RECORDS, AND THAT THE PLAT HEREON  
IS A CORRECT REPRESENTATION OF THE LOT LINES.

*Harold H. Kolb*

HAROLD H. KOLB  
WISCONSIN REGISTERED LAND SURVEYOR, S-187

DATE August 24, 1971

REVISE NOVEMBER 2, 1984

WCP-84A

11-446-K

Wm B 74