
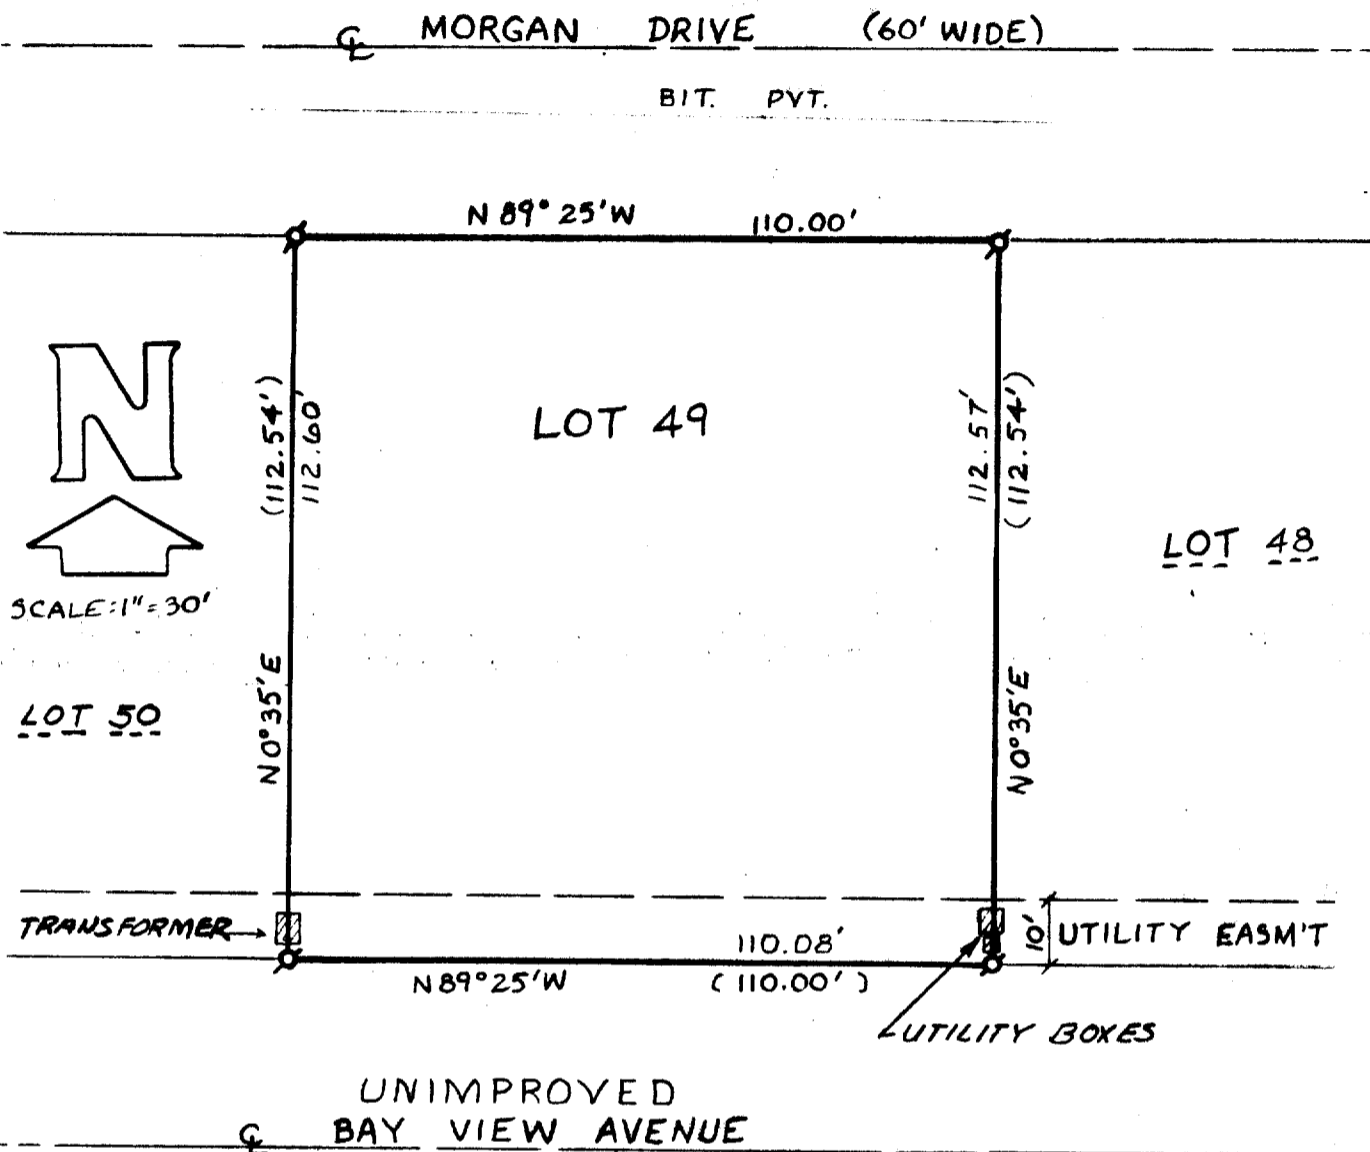


PLAT OF SURVEY OF LOT 49
WILLABAY WOODS
VILLAGE OF WILLIAMS BAY, WALWORTH CO., WISCONSIN

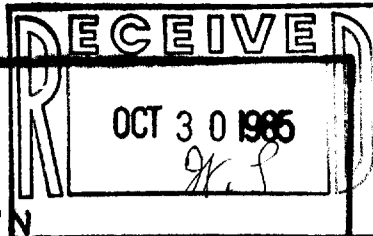

WORK ORDERED BY:
MIDWEST REALTY

LEGEND:

- ⊗ - IRON PIPE FOUND
- - IRON PIPE SET
- (XXX.XX') - RECORD DIMENSION



I HEREBY CERTIFY THAT I HAVE
SURVEYED THE ABOVE-DESCRIBED
PROPERTY AND THAT THE ABOVE MAP
IS A TRUE REPRESENTATION THEREOF
AND SHOWS THE SIZE AND LOCATION OF
THE PROPERTY, ITS EXTERIOR BOUND-
ARIES, THE LOCATION OF ALL VISIBLE
STRUCTURES AND DIMENSIONS OF ALL
PRINCIPAL BUILDINGS THEREON,
BOUNDARY FENCES, APPARENT EASE-
MENTS, ROADWAYS AND VISIBLE
ENCROACHMENTS, IF ANY.

Robert A. Farris
DATED 10/15/85

PROJ. NO. 2481

11-453-F