



RECEIVED
APR 1985
J. L.

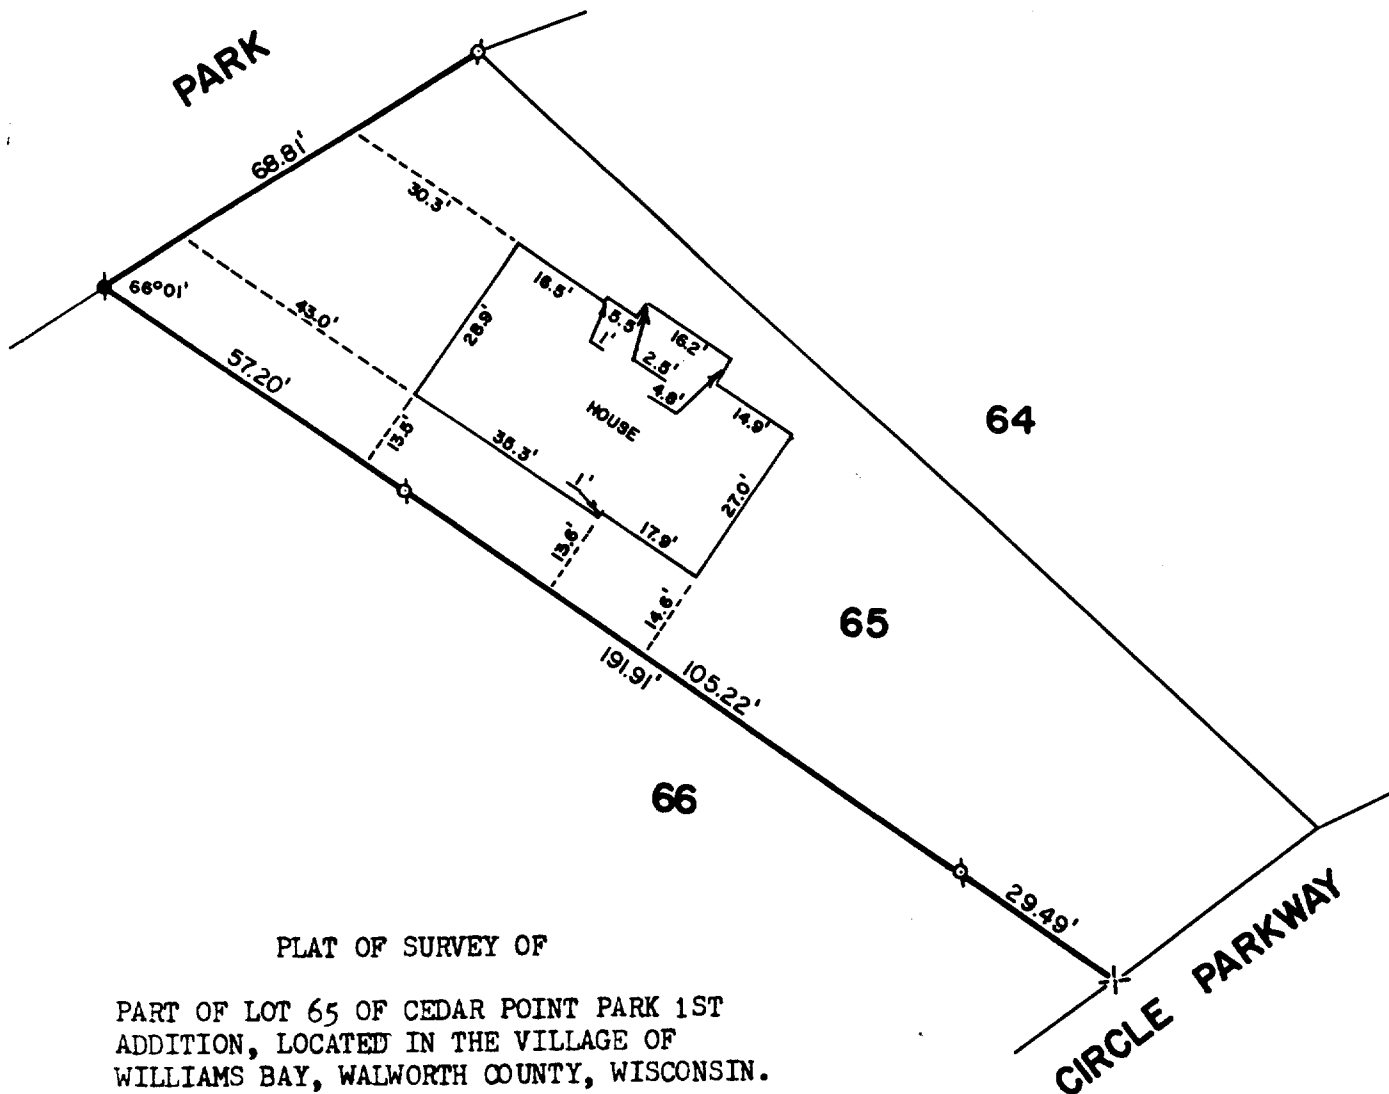

ORDERED BY: BAY CONSTRUCTION
P. O. BOX 391
WILLIAMS BAY, WISCONSIN

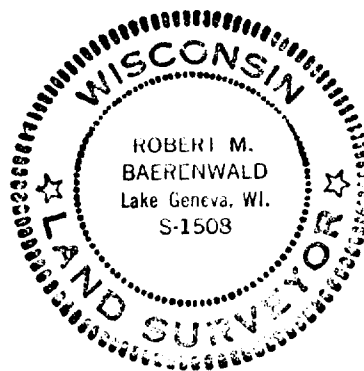

I, ROBERT M. BAERENWALD, DO HEREBY CERTIFY THAT I HAVE SURVEYED THE PROPERTY HEREON DESCRIBED ACCORDING TO THE OFFICIAL RECORDS AND THAT THE PLAT HEREON IS A CORRECT REPRESENTATION OF THE PROPERTY LINES TO THE BEST OF MY KNOWLEDGE AND BELIEF.

Ø-IRON PIPE FOUND
 ■-CONCRETE MONUMENT FOUND
 X-SPIKE FOUND AT NORTHEAST
 CORNER OF STONE PILLAR

DATE Feb. 14, 1985 JOB NO. 0203