

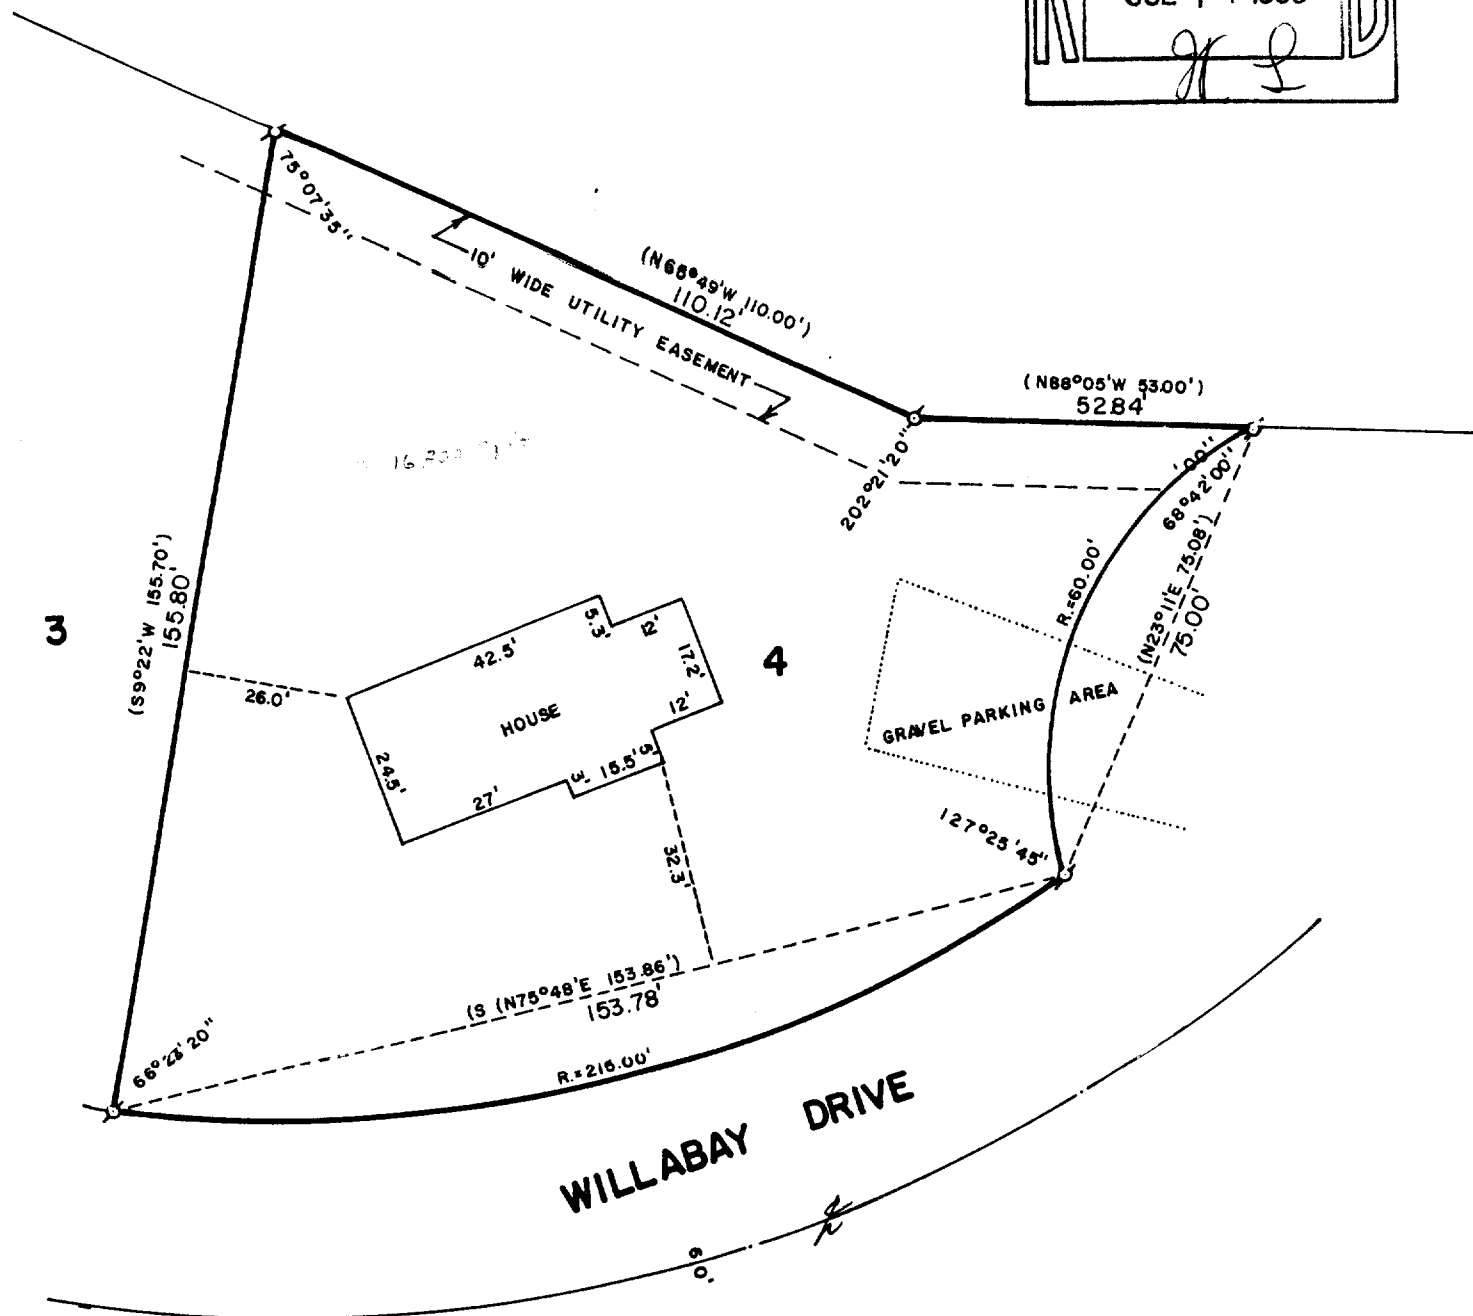


RECEIVED
JUL 11 1986
JL

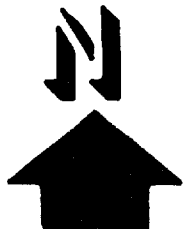

ORDERED BY: KENOSHA SAVINGS & LOAN
410 BROAD STREET
LAKE GENEVA, WISCONSIN 53147

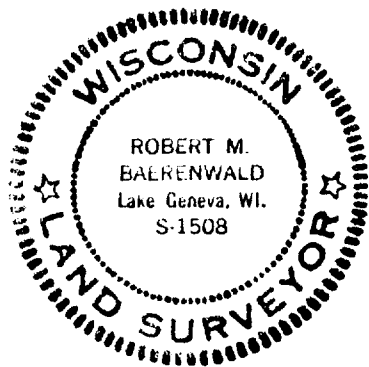

DATE 12/1/68 JOB NO. 0619

WUW-00004

11-495