

WALWORTH COUNTY SURVEYING & MAPPING LAKE GENEVA, WISCONSIN

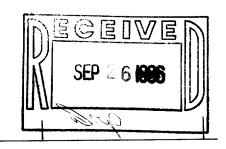

LOWER LOCH VISTA DRIVE

(50,)

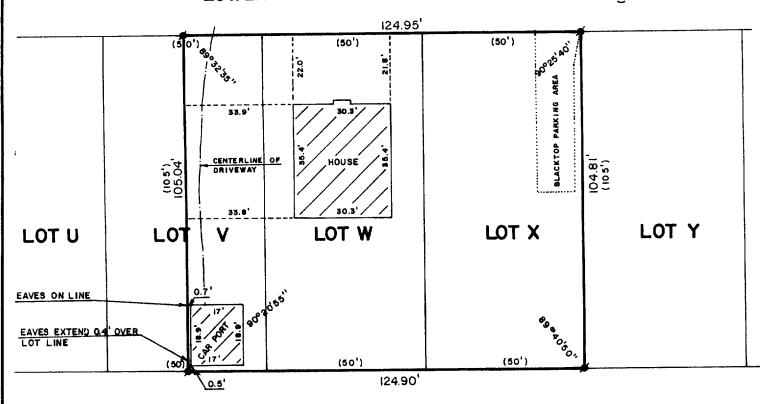

PLAT OF SURVEY OF

THE EAST 1/2 OF LOT 'V", ALL OF LOTS 'W" AND "X" OF LOCH VISTA CLUB SUBDIVISION #2, LOCATED IN THE VILLAGE OF WILLIAMS BAY, WALWORTH COUNTY, WISCONSIN.

ORDERED BY: ASSURED REALTY

P. O. BOX 367

WILLIAMS BAY, WISCONSIN



SCALE: 1"=30'

FOUND 4

I, ROBERT M. BAERENWALD, DO HEREBY CERTIFY THAT I HAVE SURVEYED THE PROPERTY HEREON DESCRIBED ACCORDING TO THE OFFICIAL RECORDS AND THAT THE PLAT HEREON IS A CORRECT REPRESENTATION OF THE PROPERTY LINES TO THE BEST OF MY KNOWLEDGE AND BELIEF.

ROBERT M. BAERENWALD

WISCONSIN REGISTERED LAND SURVEYOR, S-1508

Lest. 10, 1986

DATE JOB NO. 0678

NOTE: THIS IS NOT A CERTIFIED COPY UNLESS SEALED.

11-508