
GEORGE T. DUNHAM

SURVEYING & SUBDIVIDING DELAVAN, WISCONSIN

ELM

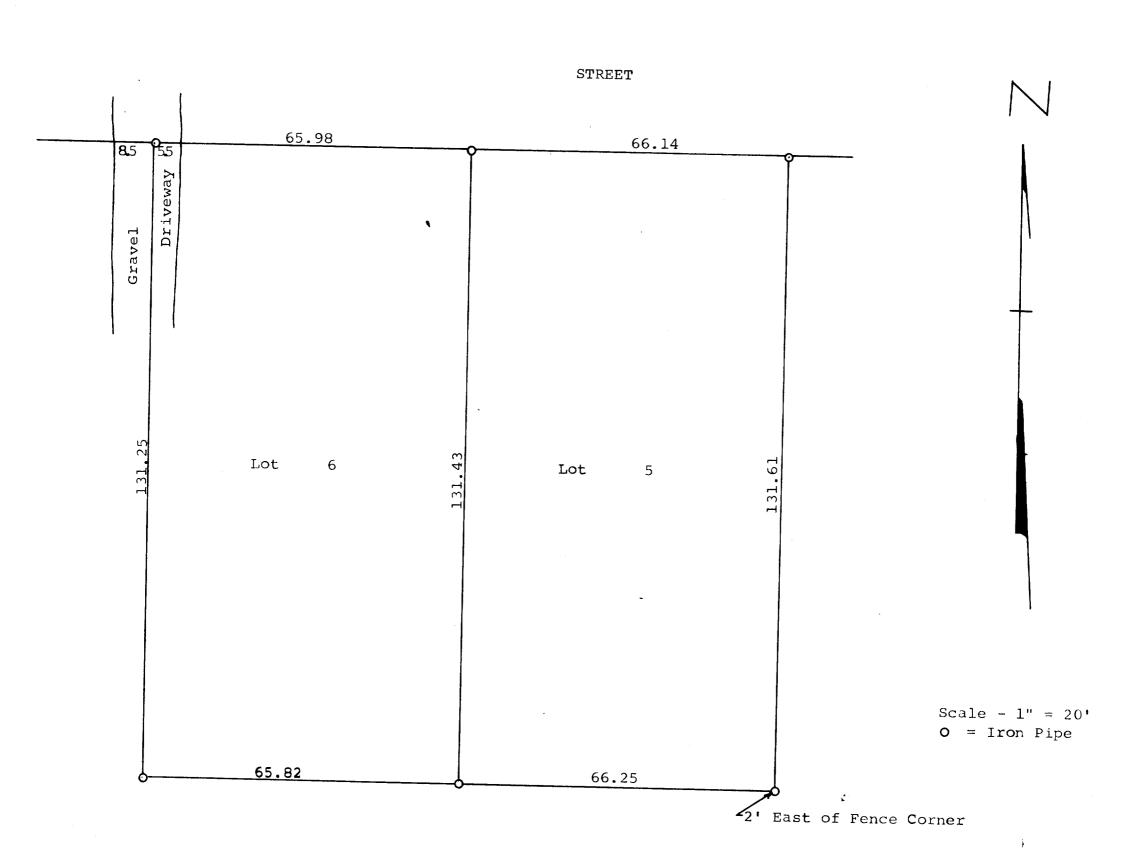

Plat of survey of Lots 5 and 6, Block 6 of the Original Plat of the Village of Williams Bay, Walworth County, Wisconsin as surveyed November 20, 1969 January 31, 1970

George T Dunham, Surveyor

11-51