
PLAT OF SURVEY of Lot 27 of Lackey Bros. Subdivision, Village of Williams Bay, Walworth County, Wisconsin.

Surveyed for: Phil Fogle.
111 Jewel Drive Jensen Surveying & Mapping S.C. 45 S. Wisconsin St. P.O. Box 322 Williams Bay, WI.53191 Elkhorn, Wisconsin. 53121 (414) 723-3434

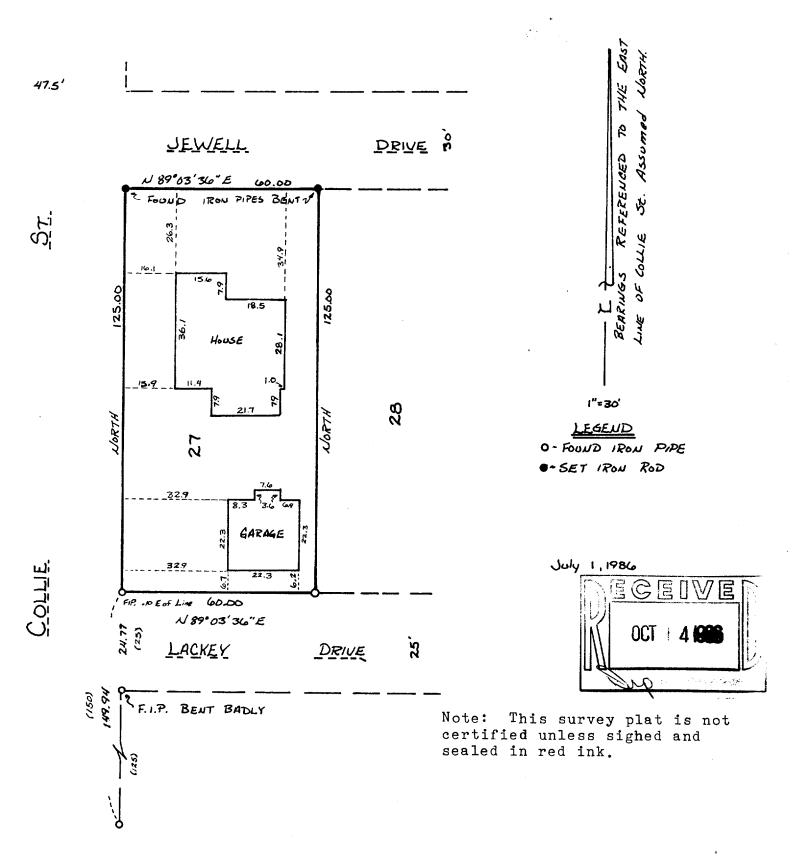

I, Thomas P.A. Jensen, Wisconsin Registered Land Surveyor, do hereby certify that this survey was performed by me, or under my direction, in full compliance with the owner's/agent's instructions and chapter A-E 5 of the Wisconsin Administrative Code "Minimum Standards For Property Surveys"; and that this map is an accurate representation thereof to the best of my knowledge and belief.